

CODED

PIKE
D70 CODED
3-68

MISSISSIPPI
 BOARD OF WATER COMMISSIONERS
 416 North State Street
 Jackson, Mississippi 39201

WATER WELL DRILLERS LOG

date well completed Mar 16 1968 firm name J. T. Corporation county well located Pike

LANDOWNER: Oliver - Ogden

description of fomations encountered

from to

McComb, Miss
(mailing address)

Bank & Sand 0 45

WELL LOCATION:

sec. 20 T. 3 N. R. 7 E. W. 1
2 miles West of McComb
 (distance) (direction) (nearest town)


WELL PURPOSE: Drain
(home, irrigation, municipal, industrial)

WELL COMPLETION DATA:

- (1) diameter (inches) 4"
- (2) total depth (feet) 45'
- (3) static water level (feet) 30' below above top of ground.
- (4) casing Plastic, 45'
(material) (depth)
 _____ if telescope see back.
 (size)
- (5) screen 6" 39'
(length) (depth to top)
4" Plastic
(size) (material)
- (6) pump 3 5
(HP) (yield gpm)
A.C.
(type power)
- (7) electric log _____
(yes or no)

(organization running log)
- (8) how well bottom plugged wood

CODED

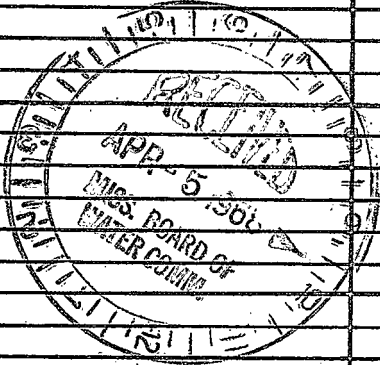

DRILLERS REMARKS:

If well telescopes please sketch and show depths.

GROUND LEVEL

			0

SECTION 20

Please indicate well location X.

ADDITIONAL INFORMATION

If more than one screen,
show locations of each on sketch.