

PIKE CODED
 D71
 3-68 CODED

MISSISSIPPI
 BOARD OF WATER COMMISSIONERS
 416 North State Street
 Jackson, Mississippi 39201

WATER WELL DRILLERS LOG

3-25-19 date well completed
 68 Leonard Water Well Pike firm name
 county well located

LANDOWNER: D.P. Dunn
 Fernwood - Miss.
 (mailing address)


description of formations encountered	from	to
sand	0	40
heavy gravel	40	45
gravel & sand	45	55
Chalk -		55

WELL LOCATION:
 sec 3 T 3 N R 8 E S W
 intown miles of Fernwood
 (distance) (direction) (nearest town)

WELL PURPOSE: home
 (home, irrigation, municipal, industrial)

- WELL COMPLETION DATA:
- (1) diameter (inches) 4
 - (2) total depth (feet) 53
 - (3) static water level (feet) 42 below top of ground.
 - (4) casing plastic 49' (material) (depth)
 - 4" if telescope see back. (size)
 - (5) screen 6' 49' (length) (depth to top)
 - 4" sch 40 (size) (material)
 - (6) pump (HP) (yield gpm)
 Elec (type power)
 - (7) electric log NO (yes or no)
 (organization running log)
 - (8) how well bottom plugged Wood peg


CODED

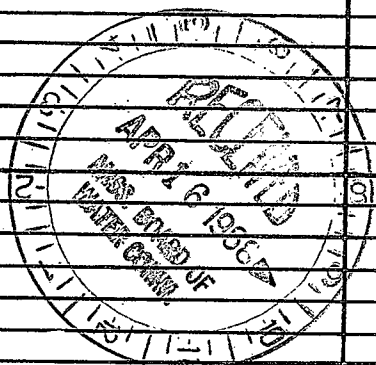

DRILLERS REMARKS:

If well telescopes please sketch and show depths.

GROUND LEVEL

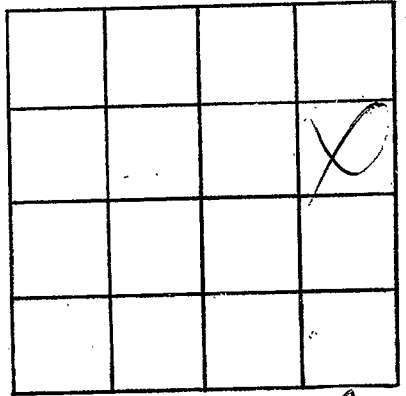

SECTION *B6*

Please indicate well location X.

ADDITIONAL INFORMATION

If more than one screen, show locations of each on sketch.