

PIKE CODED
 D72 CODED
 2-68

MISSISSIPPI
 BOARD OF WATER COMMISSIONERS
 416 North State Street
 Jackson, Mississippi 39201

WATER WELL DRILLERS LOG

March 27 1968 *Rever Well Pump* *Pike*
 date well completed firm name county well located

LANDOWNER: *F. L. Schroeder*
McComb
 (mailing address)

WELL LOCATION:
 sec *37* T *3* N R *17* E
east end of dam of
River of miles (distance) (largest town)

WELL PURPOSE: *stair*
 (home, irrigation, municipal, industrial)


- WELL COMPLETION DATA:
- (1) diameter (inches) *4"*
 - (2) total depth (feet) *55*
 - (3) static water level (feet) *33* below top of ground.
 - (4) casing *Plastic bottom*
 (material) (depth)
 (size) if telescope see back.
 - (5) screen *6'* *49'*
 (length) (depth to top)
4" *Plastic*
 (size) (material)
 - (6) pump *old pump*
 (HP) (yield gpm)
electric
 (type power)
 - (7) electric log *no*
 (yes or no)
 (organization running log)

(8) how well bottom plugged
wooden plug

DRILLERS REMARKS:
depth 33
A dry


description of formations encountered	from	to
<i>Red clay</i>	<i>0</i>	<i>12</i>
<i>clayey gravel</i>	<i>12</i>	<i>28</i>
<i>Red sand</i>	<i>28</i>	<i>35</i>
<i>small gravel and sand</i>	<i>30</i>	<i>55</i>

CODED

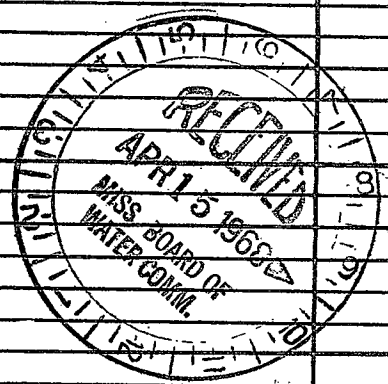

If well telescopes please sketch and show depths.

GROUND LEVEL

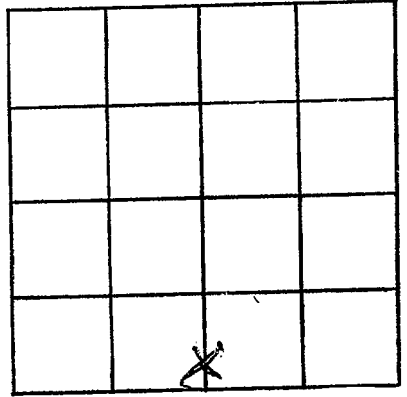

SECTION 32

Please indicate well location X.

ADDITIONAL INFORMATION

If more than one screen, show locations of each on sketch.