

CODED

Pike

D 76

CODED

5-68

MISSISSIPPI
BOARD OF WATER COMMISSIONERS
416 North State Street
Jackson, Mississippi 39201

WATER WELL DRILLERS LOG

May 1

1968

Leves well pump

Pike

date well completed

firm name

county well located

LANDOWNER: Ed D O

E. N. Achy
M. Lamb

(mailing address)

WELL LOCATION:

sec. 3 T 3 N R 7 E

1 miles W of M. Lamb (nearest town)

WELL PURPOSE: Home (home, irrigation, municipal, industrial)

WELL COMPLETION DATA:

- (1) diameter (inches) 4"
- (2) total depth (feet) 79
- (3) static water level (feet) 57 below above top of ground
- (4) casing Plastic Ballam (material) (depth)
- (5) screen 12' 67' (length) (depth) to top
4" Plastic (size) (material)
- (6) pump 20 (HPY) (yield gpm)
Electric (type power)
- (7) electric log No (yes or no)

(organization running log)

(8) how well bottom plugged Plug wooden

DRILLERS REMARKS:

New pump

description of formations encountered

from to


Red clay	0	16
Red sand	16	32
Sand & gravel	32	50
Red sand shell	50	65
Coarse sand with water pipe	65	79

CODED

JUL 10 1968 MISS. BOARD OF WATER COMMISSIONERS

If well telescopes please sketch and show depths.

GROUND LEVEL

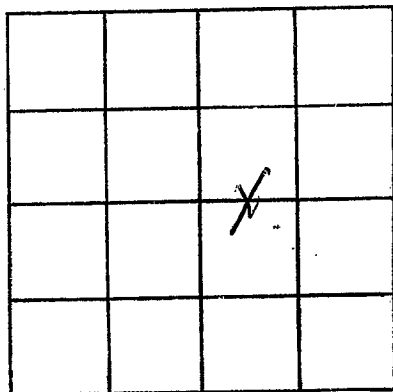

SECTION 3

Please indicate well location X.

ADDITIONAL INFORMATION

If more than one screen, show locations of each on sketch.