

**MISSISSIPPI  
BOARD OF WATER COMMISSIONERS**  
416 North State Street  
Jackson, Mississippi 39201

**WATER WELL DRILLERS LOG**

PIKE  
D 77 CODED  
8-68

Aug 5 1968 Fitzgerald well hole Pike  
date well completed firm name county well located

LANDOWNER: Frank Stibny

description of formations encountered	from	to
<u>Reel clay</u>	<u>0</u>	<u>15</u>
<u>Reel chalk</u>	<u>15</u>	<u>40</u>
<u>Reel sand</u>	<u>40</u>	<u>60</u>
<u>Reel gravel</u>	<u>60</u>	<u>85</u>
<u>Reel sand</u>	<u>85</u>	<u>90</u>
<u>Coarse sand &amp; gravel</u>	<u>90</u>	<u>115</u>

R.R. McComb, Miss.  
(mailing address)


WELL LOCATION:  
sec. 3 T. 3 N. R. 7 E.  
1 miles W of McComb  
(distance) (direction) (nearest town)

WELL PURPOSE: Home  
(home, irrigation, municipal, industrial)

**WELL COMPLETION DATA:**

- (1) diameter (inches) 4"
- (2) total depth (feet) 115
- (3) static water level (feet) 70 below above top of ground.
- (4) casing Plastic 100'  
(material) (depth)  
4" if telescope see back.  
(size)
- (5) screen 15' 100'  
(length) (depth to top)  
4" Plastic  
(size) (material)
- (6) pump 1/2 35  
(HP) (yield gpm)  
Electric  
(type power)
- (7) electric log No  
(yes or no)  
\_\_\_\_\_  
(organization running log)
- (8) how well bottom plugged wood peg


CODED

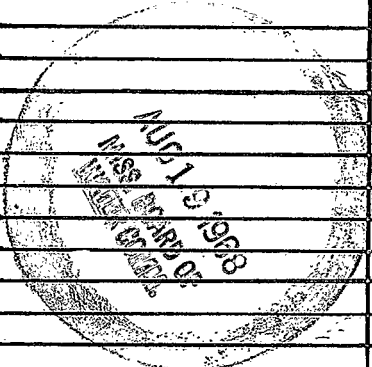

DRILLERS REMARKS: \_\_\_\_\_

If well telescopes please sketch and show depths.

GROUND LEVEL

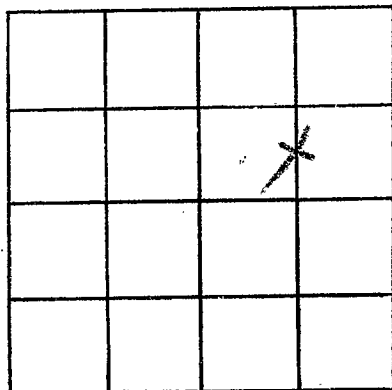

SECTION 3

Please indicate well location X.

ADDITIONAL INFORMATION

If more than one screen,  
show locations of each on sketch.