

CODED

MISSISSIPPI
BOARD OF WATER COMMISSIONERS
416 North State Street
Jackson, Mississippi 39201

WATER WELL DRILLERS LOG

Pike
D78 CODED
8-68

Aug 12 1968 J.T. Covington Pike
date well completed firm name county well located

LANDOWNER: J.W. Presler
McComb, Miss.
(mailing address)

description of formations encountered	from	to
	<u>2 clay shalts</u> <u>Spnd & Pebbles</u>	<u>0</u>


WELL LOCATION:
sec 4 T 3 N R 5 E
NW S NE W
2 miles west of McComb
(distance) (direction) (nearest town)

WELL PURPOSE: Home
(home, irrigation, municipal, industrial)

- WELL COMPLETION DATA:
- (1) diameter (inches) 4"
 - (2) total depth (feet) 142'
 - (3) static water level (feet) 103' below top of ground.
 - (4) casing Plastic, 136'
(material) (depth)
4" if telescope see back.
(size)
 - (5) screen 6' 142'
(length) (depth to top)
4" Plastic
(size) (material)
 - (6) pump 5 8
(HP) (yield gpm)
A.C.
(type power)
 - (7) electric log _____
(yes or no)


(organization running log)
 - (8) how well bottom plugged wood

DRILLERS REMARKS:

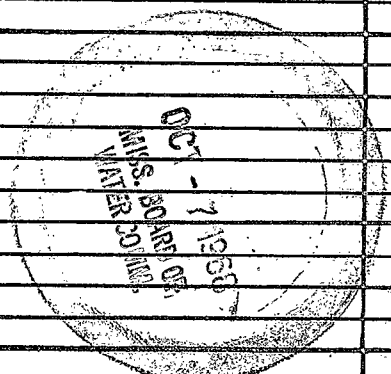

If well telescopes please sketch and show depths.

GROUND LEVEL

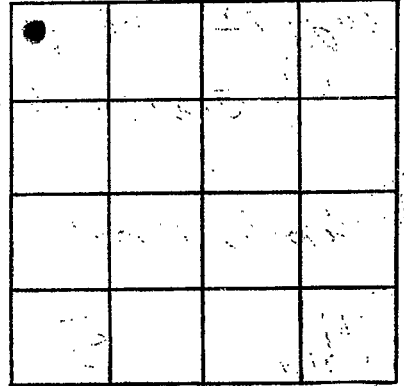

SECTION 4

Please indicate well location X.

ADDITIONAL INFORMATION

If more than one screen, show locations of each on sketch.