

CODED

D. J. [Signature]
6-14-65

WATER WELL DRILLERS LOG

CODED

Date: 6-14, 1965, Driller: Chester Reeves, County: Pike
(Name)

(1) Owner of Land: <i>Polynian Robinson</i> <i>A-3, McLamb</i> (Name) (Address)	Description & Color of Materials Sand, Clay, Red Clay, Shell, etc. <i>Red Clay</i> <i>Sand & gravel</i>	Thick- ness Feet <i>5</i> <i>43</i>	Depth Feet <i>5</i> <i>48</i>
(2) Location: $\frac{1}{4}$, $\frac{1}{4}$, Sec. <i>32</i> T. <i>3N</i> R. <i>7E</i> <i>7</i> miles <i>S. 10</i> of <i>McLamb</i> (distance) (direction) (Nearest Town)			
(3) Topography: <i>Hilly</i> (Hilly) (Flat) (Level)			
(4) Purpose of Well: <i>Domestic</i> (Domestic Irrigation Municipal, Industrial, Other)			

Information upon completion of well:

(1) Diameter *4* inches.

(2) Total Depth *48* feet.

(3) Water Level *25* feet below top of ground.


(4) Cased to *Bottom* Size *4"*

(5) Screen: Size *4"*, Length *7'*

(6) Were any formations sealed against pollution?
 _____ yes, no.

Cannot locate.

If YES depth of formation _____
Why _____
Drillers Remarks: *Newhouse*

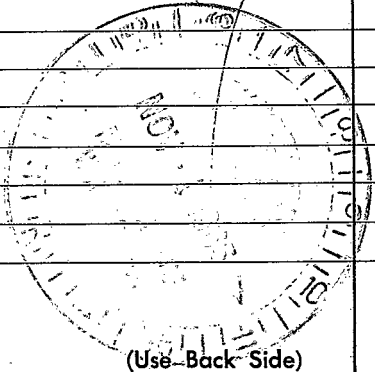

(Use-Back-Side)

Well No.

