

CODED

PIKE

MISSISSIPPI BOARD OF WATER COMMISSIONERS CODED

D 80 Count

9-10-63

WATER WELL DRILLERS LOG

Date: 9-10, 1963, Driller: Chester Reeves County: Pike  
(Name)

	Description & Color of Materials Sand, Clay, Red Clay, Shell, etc.	Thick- ness Feet	Depth Feet
(1) Owner of Land: <u>K.C. Malobum</u> (Name) <u>RFD Summit</u> (Address)	<u>Red top clay</u>	<u>10</u>	<u>10</u>
(2) Location: <u>1/4, 1/4, Sec. 9</u> <u>3N7</u> T R <u>4</u> miles <u>west</u> of <u>McLoud</u> (distance) (direction) (Nearest Town)	<u>Red cherty clay</u>	<u>40</u>	<u>50</u>
(3) Topography: <u>Hilly</u> (Hilly) (Flat) (Level)	<u>Red sand</u>	<u>65</u>	<u>115</u>
(4) Purpose of Well: <u>Domestic</u> (Domestic Irrigation Municipal, Industrial, Other)	<u>Diagonal of sand</u>	<u>13</u>	<u>128</u>


Information upon completion of well:

- (1) Diameter 4 inches.
- (2) Total Depth 128 feet.
- (3) Water Level 95 feet below top of ground.
- (4) Cased to bottom, Size 4
- (5) Screen: Size 4, Length 6'
- (6) Were any formations sealed against pollution?  
yes  no

If YES depth of formation

Why

Drillers Remarks: old well not adequate

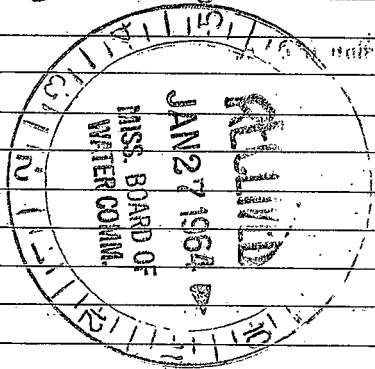

cannot locate  
RN

REEVES WELL & PUMP CO.  
P. O. BOX 71 - PHONE 694-1451  
McCOMB, MISS.

(Use Back Side)

Well No.

Retain this copy for your office files.

