

CODED

CODED

MISSISSIPPI
 BOARD OF WATER COMMISSIONERS
 416 North State Street
 Jackson, Mississippi 39201

WATER WELL DRILLERS LOG

Pike
D 81
9-11-68

9-11 1968 Fitzgerald Well Drilling Pike
 date well completed firm name county well located

LANDOWNER: Thomas Smith

description of formations encountered	from to	
	feet	feet
<u>Red clay</u>	<u>0</u>	<u>15</u>
<u>Red sand</u>	<u>15</u>	<u>75</u>
<u>Coarse sand & gravel</u>	<u>75</u>	<u>98</u>

RR. Smithdale Min.
 (mailing address)


WELL LOCATION:
 sec. 6 T. 3 N. R. 7 E.
6 miles W of Summit
 (distance) (direction) (nearest town)

WELL PURPOSE: Home
 (home, irrigation, municipal, industrial)

WELL COMPLETION DATA:


- (1) diameter (inches) 4
- (2) total depth (feet) 98
- (3) static water level (feet) 65 below above top of ground.
- (4) casing Plastic 92
 (material) (depth)
4 if telescope see back.
 (size)
- (5) screen 6 92
 (length) (depth to top)
4 Plastic
 (size) (material)
- (6) pump ? ?
 (HP) (yield gpm)
Gas
 (type power)
- (7) electric log no
 (yes or no)
(organization running log)
- (8) how well bottom plugged wood plug

DRILLERS REMARKS:

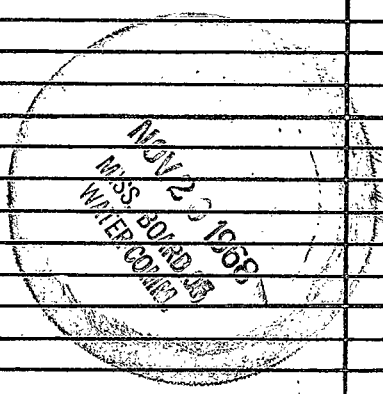

If well telescopes please sketch and show depths.

GROUND LEVEL

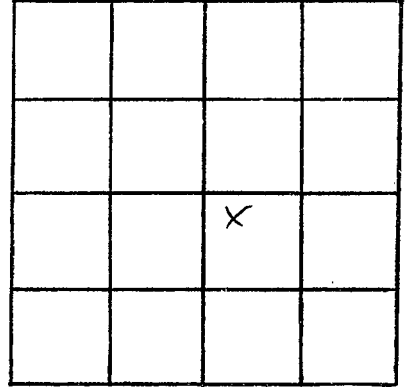

SECTION 6

Please indicate well location X.

ADDITIONAL INFORMATION

If more than one screen, show locations of each on sketch.