

CODED

PIKE CODED  
D 82  
9-30-68

MISSISSIPPI  
BOARD OF WATER COMMISSIONERS  
416 North State Street  
Jackson, Mississippi 39201

WATER WELL DRILLERS LOG

Sept 30 1968 Revere Well & Pump Co. Pike  
date/well completed firm name county well located

LANDOWNER: John  
Mc. Grew  
P.O. Box 3  
McLamb  
(mailing address)

description of formations encountered	from	to
red clay	0	17
red sand	17	24
red sandy clay	28	53
red sand	55	83
small brown gravel	83	100
coarse sand	100	106
		5 1/2
		6 1/2

WELL LOCATION:  
sect 21 T 3 N R 7 E  
2 1/2 miles WSCW McLamb  
(distance) (direction) (nearest town)

WELL PURPOSE: Home  
(home, irrigation, municipal, industrial)

WELL COMPLETION DATA:  
(1) diameter (inches) 4"  
(2) total depth (feet) 106  
(3) static water level (feet) 79 below above top of ground  
(4) casing Plastic Bottom (material) (depth)  
(size) if telescope see back.  
(5) screen 6' 100' (length) (depth to top)  
4" Plastic (size) (material)  
(6) pump 1/2 sub 10 (HP) (yield gpm)  
(type power)  
(7) electric log no (yes or no)  
(organization running log)


(8) how well bottom plugged  
wooden plug  
DRILLERS REMARKS:  
No particles well

NOV 25 1968

MISS. DE. OF  
WATER COMMISSIONERS

If well telescopes please sketch and show depths.

GROUND LEVEL

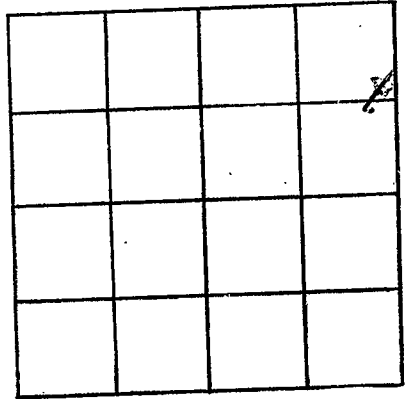

SECTION 21

Please indicate well location X.

ADDITIONAL INFORMATION

If more than one screen, show locations of each on sketch.