

Pike CODED
 D 83
 10-23-68

MISSISSIPPI
 BOARD OF WATER COMMISSIONERS
 416 North State Street
 Jackson, Mississippi 39201

CODED

WATER WELL DRILLERS LOG

Oct 23 1968 J.T. Covington Pike
 date well completed firm name county well located

LANDOWNER: San Fox & She Field

| description of formations encountered | from | to |
|---------------------------------------|------|----|
|---------------------------------------|------|----|

M^E Comb, Miss
 (mailing address)

| | | |
|----------------------|-----|-----|
| CLAY Sand & Rocks | 0 | 140 |
| | 110 | 102 |


WELL LOCATION:
 sec. 15 T. 2 N R. 7 E
 1/2 miles West of M^E Comb
 (distance) (direction) (nearest town)

WELL PURPOSE: Home
 (home, irrigation, municipal, industrial)

WELL COMPLETION DATA:


- (1) diameter (inches) 4"
- (2) total depth (feet) 102'
- (3) static water level (feet) 80' below top of ground.
- (4) casing Plastic 96' (material) (depth)
 (size) If telescope see back.
- (5) screen 6" 102' (length) (depth to top)
 4" Plastic (size) (material)
- (6) pump 7 (HP) 7 (yield gpm)
 A.C. (type power)
- (7) electric log (yes or no)
 (organization running log)
- (8) how well bottom plugged wood

DRILLERS REMARKS:

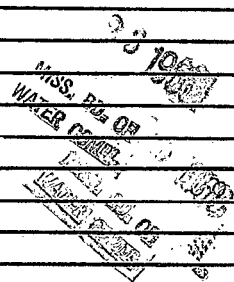

If well telescopes please sketch and show depths.

GROUND LEVEL

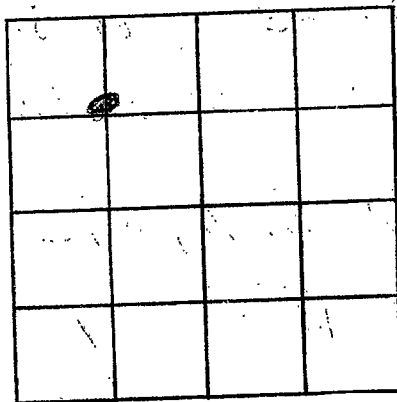

SECTION 15

Please indicate well location X.

ADDITIONAL INFORMATION

If more than one screen, show locations of each on sketch.