

Coded

Pike
D 84
8-68 CODE

MISSISSIPPI
BOARD OF WATER COMMISSIONERS
416 North State Street
Jackson, Mississippi 39201

WATER WELL DRILLERS LOG

Aug 1 1968 Reems and Kemp Co Pike
date well completed firm name county well located

LANDOWNER: Mrs. William
McMullin
Fenwood, Miss.
(mailing address)

description of formations encountered	from	to
red clay	0	18
Red Sand & gravel	18	60
Small gravel sand	60	88

WELL LOCATION:
sec 36 T 3 N R 7 E
1/2 miles SW of Fenwood
(distance) (direction) (nearest town)

WELL PURPOSE: house
(home, irrigation, municipal, industrial)


- WELL COMPLETION DATA:
- (1) diameter (inches) 4"
 - (2) total depth (feet) 88
 - (3) static water level (feet) 68 below above top of ground.
 - (4) casing Plastic, bottom (material) (depth)

- (5) screen 6' 82' (length) (depth to top)
4" Plastic (size) (material)
- (6) pump 3/4 HP 18 (type power) (yield gpm)

(7) electric log no (yes or no)
(organization running log)


(8) how well bottom plugged wooden plug

DRILLERS REMARKS: red well head

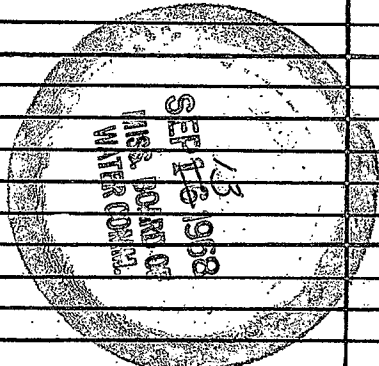

If well telescopes please sketch and show depths.

GROUND LEVEL

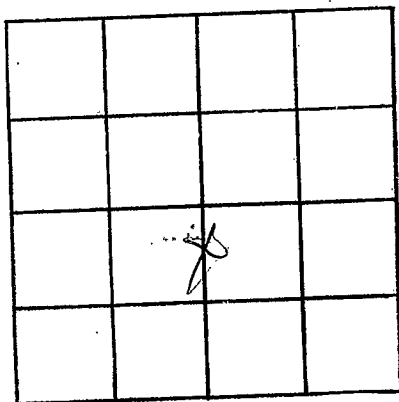

SECTION

36

Please indicate well location X.

ADDITIONAL INFORMATION

If more than one screen, show locations of each on sketch.