

CODED

Pike
D85
4-18-69

MISSISSIPPI
BOARD OF WATER COMMISSIONERS
416 North State Street
Jackson, Mississippi 39201

CODED

WATER WELL DRILLERS LOG

4-18 1969 Fatigue Well Inc Pike
date well completed firm name county well located

LANDOWNER:
C. D. Dunaway
R.R. McComb, Miss.
(mailing address)

description of formations encountered	from	to
<u>Red clay</u>	<u>0</u>	<u>20</u>
<u>Red sand</u>	<u>20</u>	<u>80</u>
<u>Coarse sand & gravel</u>	<u>80</u>	<u>90</u>

WELL LOCATION:
sec. 3 T 3 N R 7 E
S W
4 miles W of McComb
(distance) (direction) (nearest town)

WELL PURPOSE: Home
(home, irrigation, municipal, industrial)

- WELL COMPLETION DATA:
- (1) diameter (inches) 4
 - (2) total depth (feet) 90
 - (3) static water level (feet) 60 below above top of ground.
 - (4) casing Plaster 84,
(material) (depth)
4 If telescope see back.
(size)
 - (5) screen 6 84
(length) (depth to top)
4 Plastic
(size) (material)
 - (6) pump 1/2 12
(HP) (yield gpm)
Ch
(type power)
 - (7) electric log Yes
(yes or no)
(organization running log)

(8) how well bottom plugged used py

DRILLERS REMARKS:


CODED

APR 28 1969

MISS. DIV. OF WATER CONTROL

If well telescopes please sketch and show depths.

GROUND LEVEL

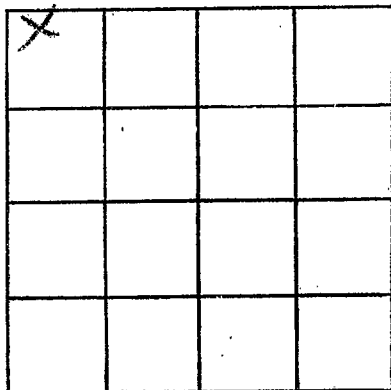

SECTION 30

Please indicate well location X.

ADDITIONAL INFORMATION

If more than one screen,
show locations of each on sketch.