

Pike
D 86
7-69

MISSISSIPPI
BOARD OF WATER COMMISSIONERS
416 North State Street
Jackson, Mississippi 39201 **CODED**

WATER WELL DRILLERS LOG

7-16 1969 Fitzgerald Well Law Pike
date well completed firm name county well located

LANDOWNER:

W.E. Summus

R.R. McComb, Miss.
(mailing address)

description of formations encountered

from to

Red Clay

0 20

Red Sand

20 80

Coarse sand & gravel

80 124

WELL LOCATION:

sec. 21 T. 3 N. R. 7 E.
S W
3 miles W of McComb
(distance) (direction) (nearest town)

WELL PURPOSE: Home
(home, irrigation, municipal, industrial)

WELL COMPLETION DATA:

- (1) diameter (inches) 4
- (2) total depth (feet) 124
- (3) static water level (feet) 85 below above top of ground.
- (4) casing Plastic 118,
(material) (depth)
4 if telescope see back.
(size)
- (5) screen 6, 118
(length) (depth to top)
4, Plastic
(size) (material)
- (6) pump 1/2 10
(HP) (yield gpm)
Electric
(type power)
- (7) electric log No
(yes or no)
(organization running log)
- (8) how well bottom plugged Wood plug

CODED


AUG 4 1969

DRILLERS REMARKS:

MISS. BD. OF
WATER COMM.

If well telescopes please
sketch and show depths.

GROUND LEVEL

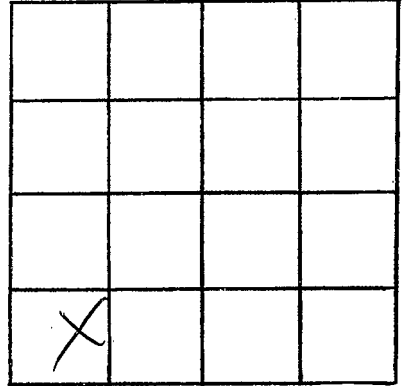

SECTION 21

Please indicate well location X.

ADDITIONAL INFORMATION

If more than one screen,
show locations of each on sketch.