

Pike Co
 D 88
 2-4-70

MISSISSIPPI
 BOARD OF WATER COMMISSIONERS
 416 North State Street
 Jackson, Mississippi 39201

CODED

WATER WELL DRILLERS LOG

16 Feb 1970 A.T. Carington, Sr. Pike Co
 date well completed firm name county well located

LANDOWNER:
 G.T. Vaccarella
 M. Comb
 (mailing address)

description of formations encountered	from	to
Clay	0	10
Sand & gravel	10	25
Sand & gravel	25	40
Sand	40	65
Sand & gravel	65	89

WELL LOCATION:
 sec 25 T 3 N R 7 E
 1 miles South of M. Comb
 (distance) (direction) (nearest town)

WELL PURPOSE: Home
 (home, irrigation, municipal, industrial)

- WELL COMPLETION DATA:
- (1) diameter (inches) 4
 - (2) total depth (feet) 89
 - (3) static water level (feet) 60 below top of ground.
 - (4) casing Pl. (material), (depth)
 4' (size) if telescope see back.
 - (5) screen 6 (length), 83 (depth to top)
 4 (size), Pl. (material)
 - (6) pump 1/2 (HP), 10 (yield gpm)
 Elec (type power)
 - (7) electric log (yes or no)
 - (organization running log)
 - (8) how well bottom plugged wood

CODED


MAR 7 9 1970

DRILLERS REMARKS:

MISS. BD. OF
 WATER COMM.

If well telescopes please sketch and show depths.

GROUND LEVEL

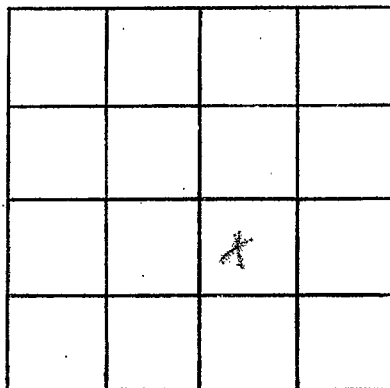

SECTION 25

Please indicate well location X.

ADDITIONAL INFORMATION

If more than one screen,
show locations of each on sketch.