

MISSISSIPPI  
BOARD OF WATER COMMISSIONERS  
416 North State Street  
Jackson, Mississippi 39201

WATER WELL DRILLERS LOG

ARITE PUMP & WELL SUPPLY CO., INC.

Pike  
D 90  
5-28-70

5-28 1970  
date well completed

firm name

Pike  
county well located

LANDOWNER: Milton Long

description of formations encountered

from

to

R 1 Box 303A

clay

0 45

Baker La

Gravel

45 55

(mailing address)

clay

55 68

Gravel

68 80

WELL LOCATION:

sec 32 T 3 N R 7 E  
3 miles W of Fernwood  
(distance) (direction) (nearest town)

WELL PURPOSE: Home  
(home, irrigation, municipal, industrial)

WELL COMPLETION DATA:

- (1) diameter (inches) 4
- (2) total depth (feet) 80
- (3) static water level (feet) 36 below top of ground. ~~above~~
- (4) casing PVC 70  
(material) (depth)  
4"  
(size) if telescope see back.
- (5) screen 10 70'  
(length) (depth to top)  
4" PVC  
(size) (material)
- (6) pump 1/2 hp 12 GPM  
(HP) (yield gpm)  
Plant  
(type power)
- (7) electric log no  
(yes or no)

(organization running log)

(8) how well bottom plugged wood


DRILLERS REMARKS:

NOV 1 - 1970

MISS. BD. OF  
WATER CO.

If well telescopes please sketch and show depths.

GROUND LEVEL

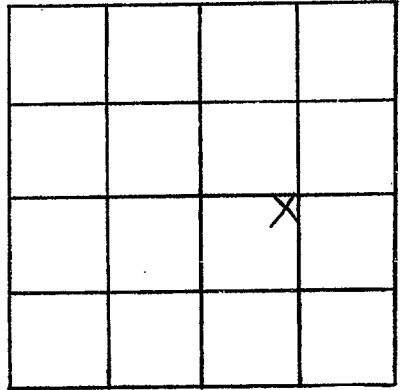

SECTION 32

Please indicate well location X.

ADDITIONAL INFORMATION

If more than one screen, show locations of each on sketch.