

Pike Co
D91
3-26-70

MISSISSIPPI
BOARD OF WATER COMMISSIONERS
416 North State Street
Jackson, Mississippi 39201

WATER WELL DRILLERS LOG

March 26 1970 Reeves Well Pump & Pits
date well completed firm name county well located

LANDOWNER: Mr. Camb
Pike County Airport
Fernwood
Mr. Camb (mailing address)
WELL LOCATION:
sec. 34 T. 3 N. R. 7 E. 065
1/2 miles W of Fernwood
(distance) (direction) (nearest town)
WELL PURPOSE: Airport
(home, irrigation, municipal, industrial)

description of formations encountered	from	to
Red clay	0	20
Red sand	20	70
Sand & gravel	70	90
Red chalk	90	105
small gravel	105	125

WELL COMPLETION DATA:
(1) diameter (inches) 4"
(2) total depth (feet) 125
(3) static water level (feet) 71 below above top of ground.
(4) casing Plastic bottom
(material) (depth)
If telescope see back.
(size)
(5) screen 10' 11.5'
(length) (depth to top)
4" Plastic
(size) (material)
(6) pump 1 1/2 30
(HP) (yield gpm)
Elect.
(type power)
(7) electric log no
(yes or no)
(organization running log)

(8) how well bottom plugged
wooden plug
DRILLERS REMARKS:
new airport


MAY 14 1970

MISS. BD. OF
WATER COM.

REEVES WELL & PUMP CO.
P. O. BOX 71 P. PHONE 684-148

If well telescopes please sketch and show depths.

GROUND LEVEL

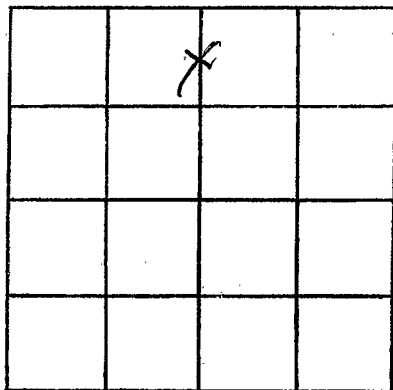

SECTION 35

Please indicate well location X.

ADDITIONAL INFORMATION

If more than one screen, show locations of each on sketch.