

PIKE
D93
7-1-70

MISSISSIPPI
BOARD OF WATER COMMISSIONERS
416 North State Street
Jackson, Mississippi 39201

CODED

WATER WELL DRILLERS LOG

July 1 1970 *Chester Kees* *Pike*
date well completed firm name county well located

LANDOWNER: *Newman Church*
RFD Summit
(mailing address)

description of formations encountered	from	to
	<i>Red clay</i>	<i>0</i>
<i>Red sand</i>	<i>6</i>	<i>10</i>
<i>Sand & gravel</i>	<i>10</i>	<i>79</i>

WELL LOCATION:
sec *31* T *30* N R *7* E
5 miles *WSE* of *Farmwood*
(distance) (direction) (nearest town)

WELL PURPOSE: *Church*
(home, irrigation, municipal, industrial)

WELL COMPLETION DATA:
(1) diameter (inches) *4 1/2*
(2) total depth (feet) *79*
(3) static water level (feet) *35* below top of ground. *above*
(4) casing *Plastic/Batten*
(material) (depth)

CODED

(size) If telescope see back.

(5) screen *6'* *73'*
(length) (depth to top)

4" *Plastic*
(size) (material)

(6) pump *sediment -*
(HP) (yield/gpm)
Electric
(type power)

(7) electric log *no*
(yes or no)

(organization running log)


(8) how well bottom plugged *wooden plug*

DRILLERS REMARKS:

SEP 15 1970

If well telescopes please sketch and show depths.

GROUND LEVEL

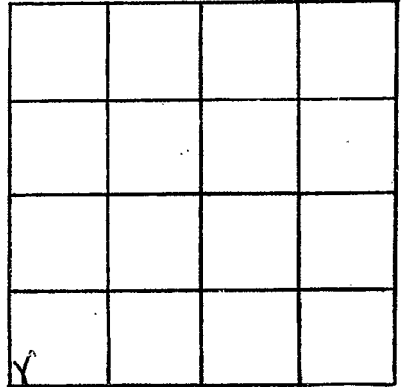

SECTION 31

Please indicate well location X.

ADDITIONAL INFORMATION

If more than one screen,
show locations of each on sketch.