

PIKE
D 94
9-3-70

MISSISSIPPI
BOARD OF WATER COMMISSIONERS
416 North State Street
Jackson, Mississippi 39201

CODED

WATER WELL DRILLERS LOG

9-3 1970 *Fitzgerald* *Pike*
date well completed firm name county well located

LANDOWNER:
B. L. Humphries
R.R. McComb, Miss
(mailing address)

description of formations encountered	from	to
<i>Red clay</i>	<i>0</i>	<i>15</i>
<i>Red sand</i>	<i>15</i>	<i>50</i>
<i>Red gravel</i>	<i>50</i>	<i>60</i>
<i>Red sand</i>	<i>60</i>	<i>90</i>
<i>Coarse sand + gravel</i>	<i>90</i>	<i>134</i>

WELL LOCATION:
sec. *5* T *3* N R *7* E
3 miles *NW* of *McComb*
(distance) (direction) (nearest town)

WELL PURPOSE: *Home*
(home, irrigation, municipal, industrial)

- WELL COMPLETION DATA:
- (1) diameter (inches) *4*
 - (2) total depth (feet) *104*
 - (3) static water level (feet) *80* below above top of ground.
 - (4) casing *plaster*, *96*,
(material) (depth)
4 If telescope see back.
(size)
 - (5) screen *3*, *96*
(length) (depth to top)
4, *plaster*
(size) (material)
 - (6) pump *1/2*, *10*
(HP) (yield gpm)
Elc
(type power)
 - (7) electric log *3*
(yes or no)
(organization running log)
 - (8) how well bottom plugged *wood plug*

CODED


DRILLERS REMARKS:

SEP 14 1970

MISS. BD. OF
WATER COMMISSIONERS

If well telescopes please sketch and show depths.

GROUND LEVEL

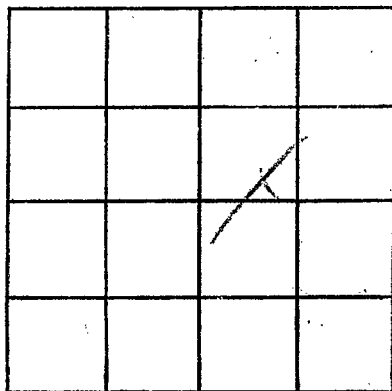

SECTION 5

Please indicate well location X.

ADDITIONAL INFORMATION

If more than one screen,
show locations of each on sketch.