

MISSISSIPPI
 BOARD OF WATER COMMISSIONERS
 416 North State Street
 Jackson, Mississippi 39201

CODED

PIKE
 095
 8-13-70

WATER WELL DRILLERS LOG

Aug 13 1970 *Chester Keller* *Pike*
 date well completed firm name county well located

LANDOWNER: *Wayne Cook*
RFD
Summit
 (mailing address)

description of formations encountered	from	to
<i>clay</i>	<i>0</i>	<i>19</i>
<i>red sand</i>	<i>19</i>	<i>55</i>
<i>gravel sand</i>	<i>55</i>	<i>70</i>

WELL LOCATION:
 sec. *8* T *3* N R *7* E
3 miles *W* of *McComb*
 (distance) (direction) (nearest town)

WELL PURPOSE: *house*
 (home, irrigation, municipal, industrial)

- WELL COMPLETION DATA:
- (1) diameter (inches) *4"*
 - (2) total depth (feet) *70'*
 - (3) static water level (feet) *45* below top of ground.
 - (4) casing *Plastic Baller*
 (material) (depth)
 - (size) if telescope see back.
 - (5) screen *6'* *6'*
 (length) (depth to top)
4" *Plastic*
 (size) (material)
 - (6) pump *1/2 Sub 15*
 (HP) (yield gpm)
Elect
 (type power)
 - (7) electric log *No*
 (yes or no)
 - (organization running log)

CODED

(8) how well bottom plugged
wooden plug


DRILLERS REMARKS:
new location

SEP 21 1970

MISS. BD. OF
 WATER COMMISSIONERS

If well telescopes please sketch and show depths.

GROUND LEVEL

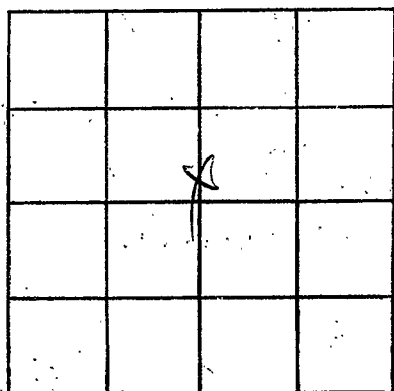

SECTION 2

Please indicate well location X.

ADDITIONAL INFORMATION

If more than one screen,
show locations of each on sketch.