

PIKE  
D96  
8-24-70

MISSISSIPPI  
BOARD OF WATER COMMISSIONERS  
416 North State Street  
Jackson, Mississippi 39201

**CODED**

WATER WELL DRILLERS LOG

Aug 24 70 date well completed  
Chester Keener firm name  
Pike county well located

LANDOWNER: Missiles Page  
#1-3  
Summit  
(mailing address)

description of formations encountered	from	to
clay	0	16
red sand	16	87
white chalk	87	102
brown sand	102	115
coarse sand	115	127

WELL LOCATION:  
sec. 15 T. 3 N R. 7 E  
2 miles SW of W. Lamb  
(distance) (direction) (nearest town)

WELL PURPOSE: Home  
(home, irrigation, municipal, industrial)

- WELL COMPLETION DATA:
- (1) diameter (inches) 4"
  - (2) total depth (feet) 127'
  - (3) static water level (feet) 80 below top of ground.
  - (4) casing Plastic Bottom  
(material) (depth)
  - (size) if telescope see back.
  - (5) screen 6' 121'  
(length) (depth to top)
  - (size) 4" Plastic  
(material)
  - (6) pump 1/2 Sub 12  
(HP) (yield gpm)
  - (type power) Electric
  - (7) electric log NO  
(yes or no)
  - (organization running log)

**CODED**


(8) how well bottom plugged  
working plug

DRILLERS REMARKS:  
old 2" Rod pump  
well rusty

SEP 21 1970

If well telescopes please sketch and show depths.

GROUND LEVEL

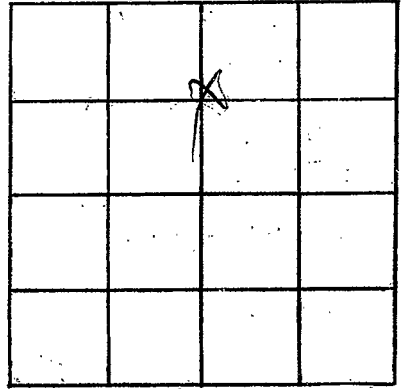

SECTION 15

Please indicate well location X.

ADDITIONAL INFORMATION

If more than one screen, show locations of each on sketch.