

PIKE

D 97

8-27-70

MISSISSIPPI BOARD OF WATER COMMISSIONERS 416 North State Street Jackson, Mississippi 39201

CODED

WATER WELL DRILLERS LOG

Aug 27 1970 date well completed

Chester Keener firm name

Pike county well located

LANDOWNER

Kaul Peterson

description of formations encountered

from

to

WELL LOCATION:

sec. 10 T. 3 N. R. 7 E

1 miles SW of McComb (distance) (direction) (nearest town)

WELL PURPOSE: Home (home, irrigation, municipal, industrial)

WELL COMPLETION DATA:

- (1) diameter (inches) 2"
(2) total depth (feet) 217
(3) static water level (feet) 51 below top of ground.
(4) casing 2' galv - battens (material) (depth)

(size) if telescope see back.

(5) screen 10 207 (length) (depth to top) 1/4 Plastic (size) (material)

(6) pump 1/2 HP 1500 (HP) (yield gpm) Elec (type power)

(7) electric log no (yes or no)

(organization running log)

(8) how well bottom plugged seen

DRILLERS REMARKS:

This well replaced salty well of Aug 5

Table with 3 columns: description of formations encountered, from, to. Rows include: clay (0-15), red sand (15-54), red chalk (54-68), sand & gravel (68-79), sump sand (79-112), gravel (112-118), white chalk (118-194), coarse sand (194-217).


CODED

11/3 1/4" Plast pipe set 5' deep with pump drilling mud - 2" well made through 4" surface casing - good fresh water -

SEP 21 1970

If well telescopes please sketch and show depths.

GROUND LEVEL

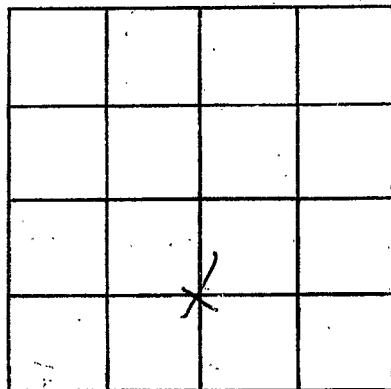

SECTION 10

Please indicate well location X.

ADDITIONAL INFORMATION

If more than one screen,  
show locations of each on sketch.