

PIKE

D 98

9-1-70

MISSISSIPPI
 BOARD OF WATER COMMISSIONERS
 416 North State Street
 Jackson, Mississippi 39201

CODED

WATER WELL DRILLERS LOG

Sept 1, 1970 Chatter Kernels Pike
 date well completed firm name county well located

LANDOWNER: Sammy Dale Clark
McLamb
 (mailing address)

description of formations encountered	from	to
<u>Clay</u>	<u>0</u>	<u>12</u>
<u>Red Sand</u>	<u>12</u>	<u>61</u>
<u>Small pebbles</u>	<u>61</u>	<u>85</u>
<u>Sand</u>		

WELL LOCATION:
 sec. 3 T. 3 N. R. 7 E
1 miles W of McLamb
 (distance) (direction) (nearest town)

WELL PURPOSE: house
 (home, irrigation, municipal, industrial)

- WELL COMPLETION DATA:
- (1) diameter (inches) 4"
 - (2) total depth (feet) 85
 - (3) static water level (feet) 55 below top of ground.
 - (4) casing Plastic bottom (material) (depth)
 - (size) if telescope see back.
 - (5) screen 6' 79' (length) (depth to top)
 - (size) 4" (material) Plastic
 - (6) pump 1/2 Sub 15 (HP) (yield gpm)
 - (type power) Electric
 - (7) electric log no (yes or no)
 - (organization running log)

CODED


(8) how well bottom plugged? wooden plug

DRILLERS REMARKS: New hand

SEP 21 1970

If well telescopes please sketch and show depths.

GROUND LEVEL

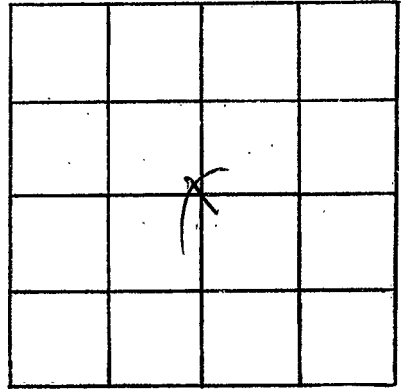

SECTION 3

Please indicate well location X.

ADDITIONAL INFORMATION

If more than one screen,
show locations of each on sketch.