

Pike
D 99
6-30-70

MISSISSIPPI
BOARD OF WATER COMMISSIONERS
416 North State Street
Jackson, Mississippi 39201

CODED

WATER WELL DRILLERS LOG

June 30 1970 Chester Kelson Pike
date well completed firm name county well located

LANDOWNER Mess. P. H.
Snacks
Fernwood -
(mailing address)

description of formations encountered	from	to
Red Sandy clay	0	20
white sand	20	50
gravel sand	50	60
small gravel	60	80

WELL LOCATION:
sec 30 T 30 N R 7 E
1/2 miles W of Fernwood
(distance) (direction) (nearest town)

WELL PURPOSE: Home
(home, irrigation, municipal, industrial)

- WELL COMPLETION DATA:
- (1) diameter (inches) 4"
 - (2) total depth (feet) 80
 - (3) static water level (feet) 50 below top of ground
 - (4) casing Plastic Ballam (material) (depth)
 - (size) if telescope see back.
 - (5) screen 6' 74' (length) (depth to top)
4" Plastic (size) (material)
 - (6) pump 1/2 HP 12 (HP) (yield gpm)
split (type power)
 - (7) electric log No (yes or no)
 - (organization running log)

CODED

(8) how well bottom plugged
wooden plug


JUL 27 1970

DRILLERS REMARKS
Edwell Rusty

MISS. Bd. of
WATER COMMISSIONERS

If well telescopes please sketch and show depths.

GROUND LEVEL

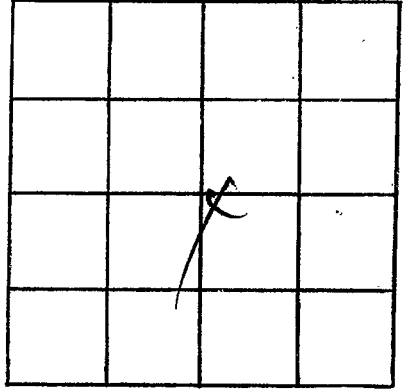

SECTION 36

Please indicate well location X.

ADDITIONAL INFORMATION

If more than one screen,
show locations of each on sketch.