

PIKE
 D100
 B-14-70

MISSISSIPPI
 BOARD OF WATER COMMISSIONERS
 416 North State Street
 Jackson, Mississippi 39201

CODED

WATER WELL DRILLERS LOG

August 14 1970 J.T. Cowling & Son PIKE
 date well completed firm name county well located

LANDOWNER:
 Row Quinn
 McComb, Miss.
 (mailing address)

description of formations encountered	from	to
CLAY	0	10
SAND	10	20
SAND + GRAVEL	20	47

WELL LOCATION:
 sec. 20 T. 3 N R. 7 E
 1/2 miles West of McComb
 (distance) (direction) (nearest town)

WELL PURPOSE: Home
 (home, irrigation, municipal, industrial)

- WELL COMPLETION DATA:
- (1) diameter (inches) 4"
 - (2) total depth (feet) 47
 - (3) static water level (feet) 10 below top of ground.
 - (4) casing Pl 41' (material) (depth)
 - (size) if telescope see back.
 - (5) screen 6' 41" (length) (depth to top)
 - 4" Pl (size) (material)
 - (6) pump 1/2 8 (HP) (yield gpm)
 - Elect (type power)
 - (7) electric log No (yes or no)
 - (organization running log)
 - (8) how well bottom plugged Wood

CODED


OCT 13 1970

DRILLERS REMARKS:

MISS. Bd. OF
 WATER COMMISSIONERS

If well telescopes please sketch and show depths.

GROUND LEVEL

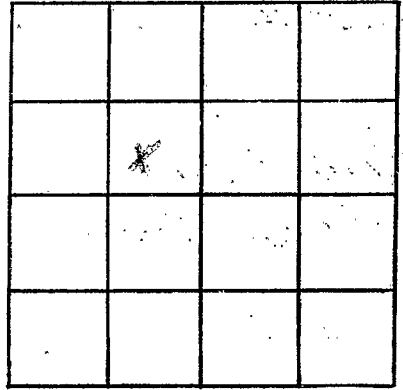

SECTION 20

Please indicate well location X.

ADDITIONAL INFORMATION

If more than one screen, show locations of each on sketch.