

PIKE
D102
9-2-70

MISSISSIPPI
BOARD OF WATER COMMISSIONERS
416 North State Street
Jackson, Mississippi 39201

CODED

WATER WELL DRILLERS LOG

Sept. 2 1970 J.T. Covington & Son Pike
date well completed firm name county well located

LANDOWNER:
Jimmy Robinson
McComb Miss.
(mailing address)

description of formations encountered	from	to
Clay	0	30
Chalk	30	80
Sandy loam & gravel	80	100
	100	130

WELL LOCATION:
sec. 9 T 3 N R 7 E
4 miles west of McComb
(distance) (direction) (nearest town)

WELL PURPOSE: Home
(home, irrigation, municipal, industrial)

- WELL COMPLETION DATA:
- (1) diameter (inches) 4
 - (2) total depth (feet) 130
 - (3) static water level (feet) 100 below top of ground.
 - (4) casing (material) 124 (depth)
(size) if telescope see back.
 - (5) screen 6 124 (length) (depth to top)
4" (size) (material)
 - (6) pump 1/2 (HP) 12 (yield gpm)
Elect (type power)
 - (7) electric log (yes or no)
 - (organization running log)
 - (8) how well bottom plugged used

CODED


DEC 7 1970

MISS. BD. OF
WATER COMM.

DRILLERS REMARKS:

If well telescopes please sketch and show depths.

GROUND LEVEL

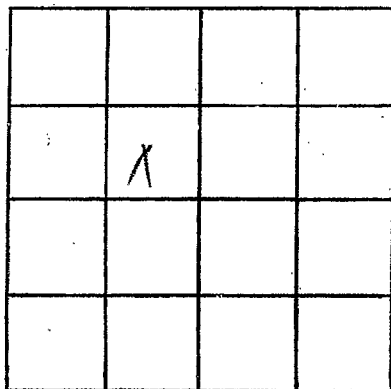

SECTION 9

Please indicate well location X.

ADDITIONAL INFORMATION

If more than one screen, show locations of each on sketch.