

PIKE
D104
11-23-70

MISSISSIPPI
BOARD OF WATER COMMISSIONERS
416 North State Street
Jackson, Mississippi 39201

CODED

WATER WELL DRILLERS LOG

23 Nov 1970 S & P Waterwell PIKE
date well completed firm name county well located

LANDOWNER:
G.R. Turnage
McComb
(mailing address)

description of formations encountered	from	to
Clay	0	20
soft shale	20	25
hard rock	25	25

WELL LOCATION:
sec 25 T 3 N R 7 E
3 miles South of McComb
(distance) (direction) (nearest town)

WELL PURPOSE:
(home, irrigation, municipal, industrial)

- WELL COMPLETION DATA:
- (1) diameter (inches) 4
 - (2) total depth (feet) 25
 - (3) static water level (feet) 40 below top of ground.
 - (4) casing (material) PL (depth) 69
(size) If telescope see back.
 - (5) screen (length) 0 (depth to top) 69
(size) PL (material)
 - (6) pump (HP) 5 (yield gpm) 10
glect (type power)
 - (7) electric log (yes or no)
 - (organization running log)
 - (8) how well bottom plugged wood

CODED


JAN 11 1971

MISS. Bd. of WATER COMMISSIONERS

DRILLERS REMARKS:

If well telescopes please sketch and show depths.

GROUND LEVEL

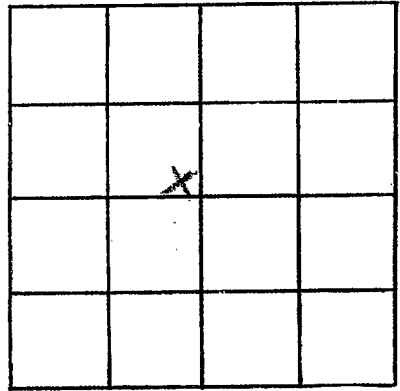

SECTION 25

Please indicate well location X.

ADDITIONAL INFORMATION

If more than one screen,
show locations of each on sketch.