

PIKE  
D105  
11-25-70

MISSISSIPPI  
BOARD OF WATER COMMISSIONERS  
416 North State Street  
Jackson, Mississippi 39201

**CODED**

WATER WELL DRILLERS LOG

25 Nov 1970 SFP Water Well Pike  
date well completed firm name county well located

LANDOWNER:  
George Beard  
McComb  
(mailing address)

description of formations encountered	from	to
clay	0	20
Red sand dy	20	45
2nd clay	45	75
sand	75	100
3rd clay	100	124

WELL LOCATION:  
sec 22 T 3 N R 7 E  
3 miles west of McComb  
(distance) (direction) (nearest town)

WELL PURPOSE:  
(home, irrigation, municipal, industrial)

- WELL COMPLETION DATA:
- (1) diameter (inches) 4
  - (2) total depth (feet) 110
  - (3) static water level (feet) 25 below top of ground.
  - (4) casing 41 (material), 110 (depth)  
(size) if telescope see back.
  - (5) screen 6 (length), 110 (depth to top)  
4 (size), 41 (material)
  - (6) pump 1/2 (HP), 10 (yield gpm)  
elect (type power)
  - (7) electric log (yes or no)

**CODED**

(organization running log)  
(8) how well bottom plugged wood


JAN 11 1971

MISS. BD. OF  
WATER COMM.

DRILLERS REMARKS:

If well telescopes please sketch and show depths.

GROUND LEVEL

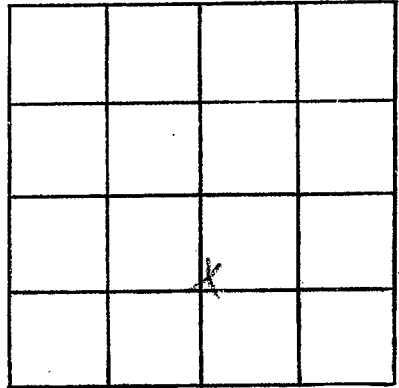

SECTION 22

Please indicate well location X.

ADDITIONAL INFORMATION

If more than one screen, show locations of each on sketch.