

PIKE
D106
12-4-70

MISSISSIPPI
 BOARD OF WATER COMMISSIONERS
 416 North State Street
 Jackson, Mississippi 39201

CODED

WATER WELL DRILLERS LOG

4 Dec 1970 S&P Waterwell Pike
 date well completed firm name county well located

LANDOWNER:

Norman Bellis Jr.

M. C. Cook
 (mailing address)

WELL LOCATION:

sec. 10 T. 3 N. R. 7 E
 & #
2 miles West of McComb
 (distance) (direction) (nearest town)

WELL PURPOSE:

(home, irrigation, municipal, industrial)

WELL COMPLETION DATA:

- (1) diameter (inches) 4
- (2) total depth (feet) 215
- (3) static water level (feet) 60 below above top of ground.
- (4) casing PI, 187
 (material) (depth)
 (size) if telescope see back.
- (5) screen 28, 187
 (length) (depth to top)
4, PI
 (size) (material)
- (6) pump 7 1/2, 125
 (HP) (yield gpm)
elect
 (type power)
- (7) electric log (yes or no)

(organization running log)

(8) how well bottom plugged wood

description of formations encountered

from to

Clay	0	20
Clay Sand	20	35
Sand Bark	35	60
Chalk	60	125
Chalk Sand	125	195
Sand Bark	195	215

CODED


JAN 19 1971

DRILLERS REMARKS:

MISS. BD. OF
 WATER COMMISSIONERS

If well telescopes please sketch and show depths.

GROUND LEVEL

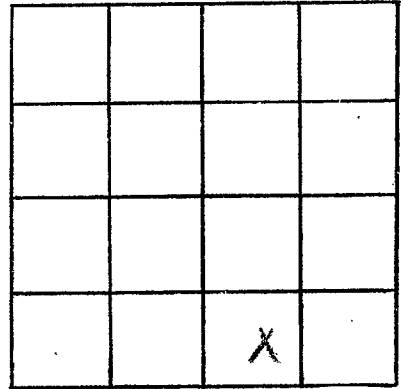

SECTION 10

Please indicate well location X.

ADDITIONAL INFORMATION

If more than one screen,
show locations of each on sketch.