

PIKE  
 D107  
 12-22-70

MISSISSIPPI  
 BOARD OF WATER COMMISSIONERS  
 416 North State Street  
 Jackson, Mississippi 39201

**CODED**

WATER WELL DRILLERS LOG

22 Dec 1970 S&P Water Well PIKE  
 date well completed firm name county well located

LANDOWNER: Marty Bass  
Summit  
 (mailing address)

description of formations encountered	from	to
<u>Clay</u>	<u>0</u>	<u>20</u>
<u>Red Sand</u>	<u>20</u>	<u>60</u>
<u>Chalk Sand</u>	<u>60</u>	<u>85</u>
<u>Sand</u>	<u>85</u>	<u>125</u>

WELL LOCATION:  
 sec. 15 T. 3 N R. 7 E  
2 miles West of McComb  
 (distance) (direction) (nearest town)

WELL PURPOSE:  
 (home, irrigation, municipal, industrial)

- WELL COMPLETION DATA:
- (1) diameter (inches) 14
  - (2) total depth (feet) 125
  - (3) static water level (feet) 80 below above top of ground.
  - (4) casing PI 119  
 (material) (depth)  
 (size) if telescope see back.
  - (5) screen 6 119  
 (length) (depth to top)  
PI  
 (size) (material)
  - (6) pump 5 10  
 (HP) (yield gpm)  
Electric  
 (type power)
  - (7) electric log (yes or no)
  - (organization running log)
  - (8) how well bottom plugged wood

**CODED**


JAN 19 1971

DRILLERS REMARKS:

MISS. BD. OF  
 WATER COMMISSIONERS

If well telescopes please sketch and show depths.

GROUND LEVEL

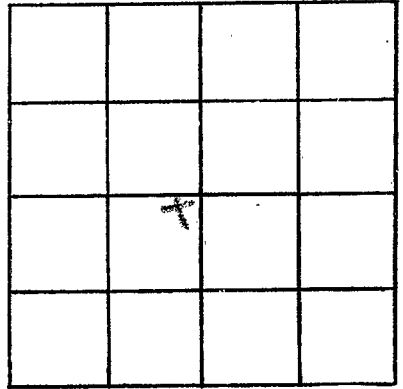

SECTION 12

Please indicate well location X.

ADDITIONAL INFORMATION

If more than one screen, show locations of each on sketch.