

MISSISSIPPI
BOARD OF WATER COMMISSIONERS
416 North State Street
Jackson, Mississippi 39201

CODED

WATER WELL DRILLERS LOG

PIKE
D 109
5-16-69

May 16 69 date well completed
Levee Well Drilling Co. firm name
Pike county well located

LANDOWNER: E.
C. Williams
A. D. Summit
(mailing address)

description of formations encountered	from	to
Red clay	0	19
Red sand	19	65
swab sand	65	95
yellow sand	95	95
hard sand	95	99
fine gravel sand		

WELL LOCATION:
sec. 24 T. 3 N R. 7 E
1 1/2 miles SW of McComb
(distance) (direction) (nearest town)

WELL PURPOSE: Same
(home, irrigation, municipal, industrial)

- WELL COMPLETION DATA:
- (1) diameter (inches) 4"
 - (2) total depth (feet) 99
 - (3) static water level (feet) 67 below top of ground
 - (4) casing (material) Plastic ballam (depth)
 - (5) screen (size) 6' (length) 93' (depth to top) Plastic (material)
 - (6) pump (HP) 1/2 (yield gpm) 12
Flex (type power)
 - (7) electric log No (yes or no)
- (organization running log)

CODED

(8) how well bottom plugged
wooden plug


DRILLERS REMARKS:
old 2" well head

AUG 15 1969

Miss. Bd. OF WATER COMMISSIONERS

If well telescopes please sketch and show depths.

GROUND LEVEL

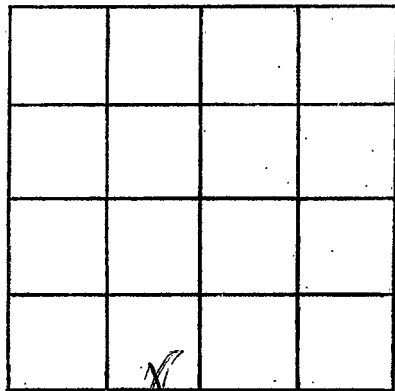

SECTION 10

Please indicate well location X.

ADDITIONAL INFORMATION

If more than one screen, show locations of each on sketch.