

PIKE
D 110
6124-69

MISSISSIPPI
BOARD OF WATER COMMISSIONERS
416 North State Street
Jackson, Mississippi 39201

CODED

WATER WELL DRILLERS LOG

Completed 1969 Reeves and Thompson Pike
date well completed firm name county well located

LANDOWNER Samsco
oil Co -
McLamb, Miss.
(mailing address)

description of formations encountered	from	to
Red clay	0	24
Red sand	29	72
Small gravel Sand	72	93

WELL LOCATION:
sec. 34 T. 3 N. R. 7 E
2 miles W of Farmington
(distance) (direction) (nearest town)

WELL PURPOSE: Commercial
(home, irrigation, municipal, industrial)

WELL COMPLETION DATA:

(1) diameter (inches) 4"

(2) total depth (feet) 93

(3) static water level (feet) 65 below above top of ground

(4) casing Plastic hollow
(material) (depth)

(size) if telescope see back.

(5) screen 6' 8.7'
(length) (depth to top)

12" Plastic
(size) (material)

(6) pump 3/4 Sub-15
(HP) (yield gpm)

Direct
(type power)

(7) electric log no
(yes or no)

(organization running log)

CODED


(8) how well bottom plugged
wooden plug

DRILLERS REMARKS:
new location

APR 20 1969
MISSISSIPPI
WATER BOARD

If well telescopes please sketch and show depths.

GROUND LEVEL

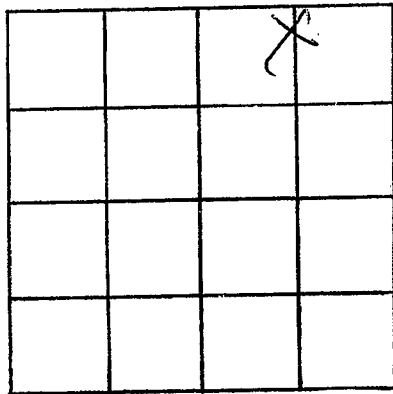

SECTION 314

Please indicate well location X.

ADDITIONAL INFORMATION

If more than one screen, show locations of each on sketch.