

Oike  
DIII  
8-15-69

MISSISSIPPI  
 BOARD OF WATER COMMISSIONERS  
 416 North State Street  
 Jackson, Mississippi 39201

**CODED**

WATER WELL DRILLERS LOG

8-15 1969 Fitzgerald well Inc Oike  
 date well completed firm name county well located

LANDOWNER:  
Sam Alford  
m<sup>c</sup> Comb, Miss  
 (mailing address)

description of formations encountered	from	to
<u>Red Clay</u>	<u>0</u>	<u>15</u>
<u>Red Sand</u>	<u>15</u>	<u>40</u>
<u>Coarse Sand &amp; gravel</u>	<u>40</u>	<u>89</u>

WELL LOCATION:  
 sec. 3 T 3 N R 7 E  
1 miles W of m<sup>c</sup> Comb  
 (distance) (direction) (nearest town)

WELL PURPOSE: Home  
 (home, irrigation, municipal, industrial)

- WELL COMPLETION DATA:
- (1) diameter (inches) 4
  - (2) total depth (feet) 89
  - (3) static water level (feet) 35 below above top of ground.
  - (4) casing Plastic, 83  
 (material) (depth)  
4 If telescope see back.  
 (size)
  - (5) screen 6, 83  
 (length) (depth to top)  
4, Plastic  
 (size) (material)
  - (6) pump 1/2, 10  
 (HP) (yield gpm)  
Electric  
 (type power)
  - (7) electric log no  
 (yes or no)  
 (organization running log)
  - (8) how well bottom plugged woolly

**CODED**


SEP 18 1969

MISSISSIPPI  
 BOARD OF WATER COMMISSIONERS

DRILLERS REMARKS:

If well telescopes please sketch and show depths.

GROUND LEVEL

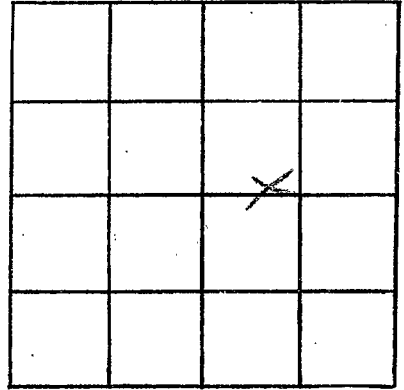

SECTION 3

Please indicate well location X.

ADDITIONAL INFORMATION

If more than one screen,  
show locations of each on sketch.