

Pike
D 113
2-9-70

MISSISSIPPI
BOARD OF WATER COMMISSIONERS
416 North State Street
Jackson, Mississippi 39201

CODED

WATER WELL DRILLERS LOG

2-9-70 date well completed 1970 firm name *Fitzgerald and Son* county well located *Pike*

LANDOWNER:
Dorothy Watts
R.R. Magnolia, Miss.
(mailing address)

WELL LOCATION:
sec. *34* T. *3* N. R. *7* E
1 1/2 miles NNW of *Magnolia*
(distance) (direction) (nearest town)

WELL PURPOSE: *Home*
(home, irrigation, municipal, industrial)

- WELL COMPLETION DATA:
- (1) diameter (inches) 4
 - (2) total depth (feet) 122
 - (3) static water level (feet) 85 below above top of ground.
 - (4) casing *Plastic* *114*
(material) (depth)
4 If telescope see back.
(size)
 - (5) screen *8* *114*
(length) (depth to top)
4 *Plastic*
(size) (material)
 - (6) pump *3/4* *5*
(HP) (yield gpm)
Elco
(type power)
 - (7) electric log *No*
(yes or no)
(organization running log)
 - (8) how well bottom plugged *as usual per*

description of formations encountered	from	to
<i>Red clay</i>	<i>0</i>	<i>20</i>
<i>Red sand</i>	<i>20</i>	<i>60</i>
<i>Red gravel</i>	<i>60</i>	<i>98</i>
<i>Coarse sand & gravel</i>	<i>98</i>	<i>122</i>

CODED


FEB 27 1970

MISS. BD. OF
WATER COMM.

DRILLERS REMARKS:

If well telescopes please sketch and show depths.

GROUND LEVEL

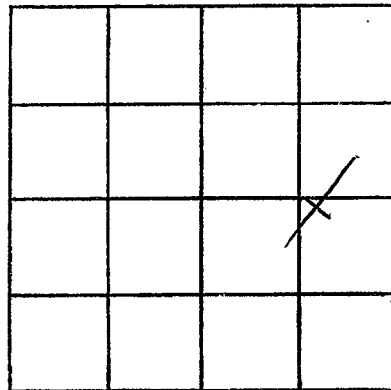

SECTION 34

Please indicate well location X.

ADDITIONAL INFORMATION

If more than one screen,
show locations of each on sketch.