

PIKE
D 114
10-31-69

MISSISSIPPI
BOARD OF WATER COMMISSIONERS
416 North State Street
Jackson, Mississippi 39201

CODED

WATER WELL DRILLERS LOG

10-31 1969 Fitzgerald well ser Pike
date well completed firm name county well located

LANDOWNER:
Mr. E. J. Bridges
R.R. Summit, Miss.
(mailing address)

description of formations encountered	from	to
<u>Red clay</u>	<u>0</u>	<u>15</u>
<u>Red soil</u>	<u>15</u>	<u>60</u>
<u>Loose sub & gravel</u>	<u>60</u>	<u>80</u>

WELL LOCATION:
sec. 8 T 3 N R 7 W
4 miles SW of Summit
(distance) (direction) (nearest town)

WELL PURPOSE: Home
(home, irrigation, municipal, industrial)

- WELL COMPLETION DATA:
- (1) diameter (inches) 4
 - (2) total depth (feet) 80
 - (3) static water level (feet) 50 below top of ground.
 - (4) casing plastic, 74,
(material) (depth)
4 if telescope see back.
(size)
 - (5) screen 6, 74
(length) (depth to top)
4, plastic
(size) (material)
 - (6) pump 1, 5
(HP) (yield gpm)
elec
(type power)
 - (7) electric log no
(yes or no)
(organization running log)
 - (8) how well bottom plugged wood pin

CODED


NOV 21 1969

MISS. REG. ON
WATER WELLS

DRILLERS REMARKS:

If well telescopes please sketch and show depths.

GROUND LEVEL

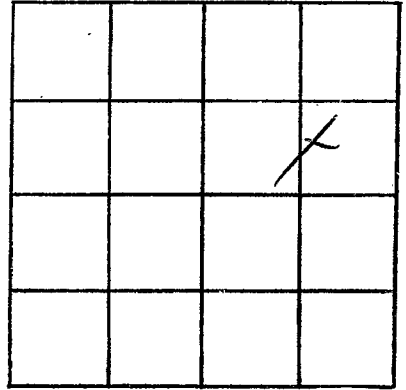

SECTION 8

Please indicate well location X.

ADDITIONAL INFORMATION

If more than one screen,
show locations of each on sketch.