

PIKE  
D 115  
11-7-69

MISSISSIPPI  
BOARD OF WATER COMMISSIONERS  
416 North State Street  
Jackson, Mississippi 39201

**CODED**

WATER WELL DRILLERS LOG

11-7 1969 Fitzgerald well serv Pike  
date well completed firm name county well located

LANDOWNER:  
Leady Crawford  
R.R. Summit Miss.  
(mailing address)

description of formations encountered	from	to
<u>Red gravel</u>	<u>0</u>	<u>15</u>
<u>Red shale</u>	<u>15</u>	<u>90</u>
<u>Red gravel</u>	<u>90</u>	<u>115</u>
<u>Coarse sand &amp; gravel</u>	<u>115</u>	<u>125</u>

WELL LOCATION:  
sec. 17 T. 3 N. R. 1 E  
5 miles W of McComb  
(distance) (direction) (nearest town)

WELL PURPOSE: Home  
(home, irrigation, municipal, industrial)

- WELL COMPLETION DATA:
- (1) diameter (inches) 4
  - (2) total depth (feet) 125
  - (3) static water level (feet) 80 below top of ground.
  - (4) casing Plaster, 119,  
(material) (depth)  
4 if telescope see back.  
(size)
  - (5) screen 6, 119  
(length) (depth to top)  
4, Plaster  
(size) (material)
  - (6) pump 1/2, 12  
(HP) (yield gpm)  
Electric  
(type power)
  - (7) electric log no  
(yes or no)  
(organization running log)
  - (8) how well bottom plugged wood plug

**CODED**


NOV 21 1969

DRILLERS REMARKS:

MISSISSIPPI  
BOARD OF WATER COMMISSIONERS

If well telescopes please sketch and show depths.

GROUND LEVEL

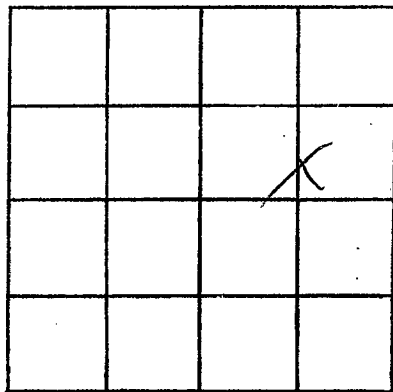

SECTION 14

Please indicate well location X.

ADDITIONAL INFORMATION

If more than one screen,  
show locations of each on sketch.