

MISSISSIPPI  
BOARD OF WATER COMMISSIONERS  
416 North State Street  
Jackson, Mississippi 39201

**CODED**

WATER WELL DRILLERS LOG

Pike  
D117  
10-28-69

Oct 28 1969 date well completed      69 River well & pumps firm name      Pike county well located

LANDOWNER: Kenneth R Thompson  
Rt - 2 Summit  
(mailing address)

description of formations encountered	from	to
<u>Red clay</u>	<u>0</u>	<u>19</u>
<u>Red chert</u>	<u>19</u>	<u>42</u>
<u>Red sand</u>	<u>42</u>	<u>85</u>
<u>Coarse sand &amp; small gravel</u>	<u>85</u>	<u>100</u>

WELL LOCATION:  
sec. 4 T. 3 N. R. 7 E.  
2 miles West of McComb  
(distance) (direction) (nearest town)

WELL PURPOSE: Home  
(home, irrigation, municipal, industrial)

WELL COMPLETION DATA:

(1) diameter (inches) 4"

(2) total depth (feet) 100

(3) static water level (feet) 59 below top of ground.

(4) casing Waste, galv  
(material) (depth)

\_\_\_\_\_ if telescope see back.  
(size)

(5) screen 6' 94'  
(length) (depth to top)

4' plastic  
(size) (material)

(6) pump old galv  
(HP) (yield gpm)

Elect  
(type power)

(7) electric log no  
(yes or no)

\_\_\_\_\_ (organization running log)

**CODED**

DEC 31 1969


(8) how well bottom plugged wood chips

DRILLERS REMARKS: new house

MISS. BD. OF  
WATER COMMISSIONERS

If well telescopes please sketch and show depths.

GROUND LEVEL

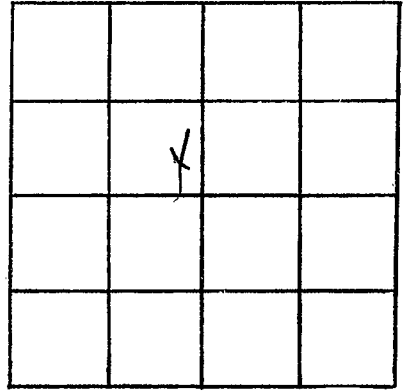

SECTION 4

Please indicate well location X.

ADDITIONAL INFORMATION

If more than one screen,  
show locations of each on sketch.