

MISSISSIPPI
BOARD OF WATER COMMISSIONERS
416 North State Street
Jackson, Mississippi 39201

CODED

WATER WELL DRILLERS LOG

Pike
D 118,
10-31-69

Oct 31 1969 date well completed
69 Renewwell Drillers firm name
Pike county well located

LANDOWNER: Am. M. Muller

description of formations encountered

from to

Fernwood

Red clay
Red chalky sand

0 23
23 78

(mailing address)

WELL LOCATION:

sec. 36 T 3 N R. 7 E
3/4 miles W of Fernwood
(distance) (direction) (nearest town)

gravel
Red chalk
Red sand

78 95
95 106
106 130
130 130

WELL PURPOSE: Home
(home, irrigation, municipal, industrial)

WELL COMPLETION DATA:

- (1) diameter (inches) 4"
- (2) total depth (feet) 130
- (3) static water level (feet) 96 below top of ground.
- (4) casing Plastic bottom
(material) (depth)
- (size) if telescope see back.
- (5) screen 6 120'
(length) (depth to top)
4' plastic
(size) (material)
- (6) pump 1/2 Sub - 1/2
(HP) (yield gpm)
split
(type power)
- (7) electric log No
(yes or no)

CODED

(organization running log)


(8) how well bottom plugged
wood chips
DRILLERS REMARKS:
new house.

DEC 31 1969

MISS. BD. OF
WATER COMM.

If well telescopes please sketch and show depths.

GROUND LEVEL

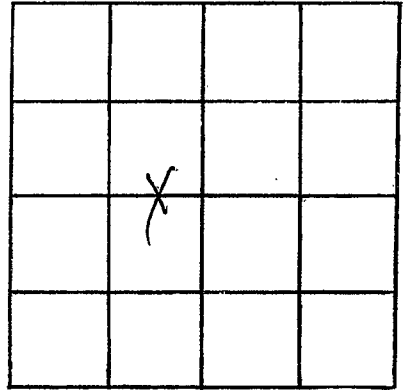

SECTION 36

Please indicate well location X.

ADDITIONAL INFORMATION

If more than one screen,
show locations of each on sketch.