

PIKE
 D120
 1-15-70

MISSISSIPPI
 BOARD OF WATER COMMISSIONERS
 416 North State Street
 Jackson, Mississippi 39201

CODED

WATER WELL DRILLERS LOG

1-15 1970 Fitzgerald Well Service Pike
 date well completed firm name county well located

LANDOWNER:	description of formations encountered	from	to
<u>M. D. Hales the Co.</u>			
<u>R.R. Magnolia Miss.</u> (mailing address)	<u>red clay</u>	<u>0</u>	<u>15</u>
	<u>coarse sand & gravel</u>	<u>15</u>	<u>73</u>

WELL LOCATION:
 sec. 36 T. 3 N R. 7 E
 S W
1 miles S of Farmwood
 (distance) (direction) (nearest town)

WELL PURPOSE: Home
 (home, irrigation, municipal, industrial)

- WELL COMPLETION DATA:
- (1) diameter (inches) 4
 - (2) total depth (feet) 73
 - (3) static water level (feet) 30 below above top of ground.
 - (4) casing plastic, 65
 (material) (depth)
4 if telescope see back.
 (size)
 - (5) screen 8, 65
 (length) (depth to top)
4 (size) plastic (material)
 - (6) pump 3/4, 6
 (HP) (yield gpm)
electric
 (type power)
 - (7) electric log no
 (yes or no)
 (organization running log)
 - (8) how well bottom plugged blow pipe

CODED


JAN 20 1970

MISS. BD. OF
 WATER COM.

DRILLERS REMARKS:

If well telescopes please sketch and show depths.

GROUND LEVEL

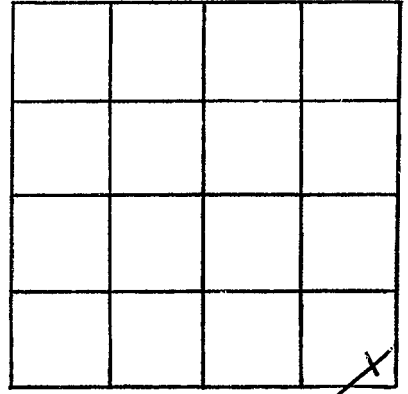

SECTION 36

Please indicate well location X.

ADDITIONAL INFORMATION

If more than one screen,
show locations of each on sketch.