

MISSISSIPPI
BOARD OF WATER COMMISSIONERS
416 North State Street
Jackson, Mississippi 39201

CODED

B 19 1971
MISS. BD. OF
WATER COMMISSIONERS

WATER WELL DRILLERS LOG

PIKE
D121
2-11-71

Feb 11 1971 date well completed
Chester Kernes firm name
county well located

LANDOWNER: Glendon
Moak
RFD Summit
(mailing address)

description of formations encountered	from	to
clay	0	18
Sand & gravel	18	30
clay	30	50
Sand & gravel	50	73

WELL LOCATION:
sec. 6 T. 3 N. R. 7 E
4-5 miles W McComb
(distance) (direction) (nearest town)

WELL PURPOSE: Home Steady
(home, irrigation, municipal, industrial)

- WELL COMPLETION DATA:
- (1) diameter (inches) 4"
 - (2) total depth (feet) 73
 - (3) static water level (feet) 26 below top of ground.
 - (4) casing Plast Ballon
(material) (depth)
(size) if telescope see back.
 - (5) screen 6' 6.7'
(length) (depth to top)
1/2" Plast
(size) (material)
 - (6) pump 3/4 sub 15
(HP) (yield gpm)
Elect
(type power)
 - (7) electric log No
(yes or no)


CODED

(organization running log)
(8) how well bottom plugged working plug

DRILLERS REMARKS:
old well not sufficient

If well telescopes please sketch and show depths.

GROUND LEVEL

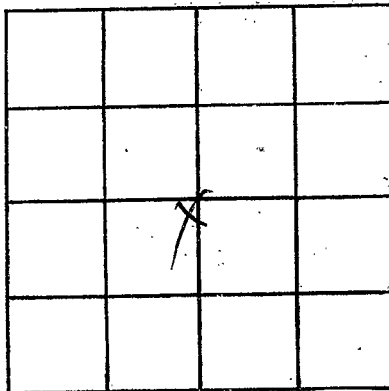

SECTION 6

Please indicate well location X.

ADDITIONAL INFORMATION

If more than one screen, show locations of each on sketch.