

PIKE
D122
1-6-71

MISSISSIPPI
BOARD OF WATER COMMISSIONERS
416 North State Street
Jackson, Mississippi 39201

CODED

WATER WELL DRILLERS LOG

6 Jan 1971 S & P Waterwell firm name Pike county well located

LANDOWNER:
Skillcraft Inc.
(mailing address)

| description of formations encountered | from | to |
|---------------------------------------|------|-----|
| Clay | 0 | 25 |
| Red Sand | 25 | 60 |
| Chalk Sand | 60 | 85 |
| Sand | 85 | 123 |

WELL LOCATION:
sec 15 T 3 N R 7 E
2 miles West of McComb
(distance) (direction) (nearest town)

WELL PURPOSE: Home
(home, irrigation, municipal, industrial)

WELL COMPLETION DATA:

(1) diameter (inches) 4

(2) total depth (feet) 123

(3) static water level (feet) 92 below above top of ground.

(4) casing PI 117
(material) (depth)
(size) If telescope see back.

(5) screen 6 117
(length) (depth to top)
4 PI
(size) (material)

(6) pump 2 8
(HP) (yield gpm)
Electric
(type power)

(7) electric log (yes or no)
(organization running log)

(8) how well bottom plugged wood

CODED


FEB 26 1971

MISS. BD. OF
WATER COM.

DRILLERS REMARKS:

If well telescopes please sketch and show depths.

GROUND LEVEL

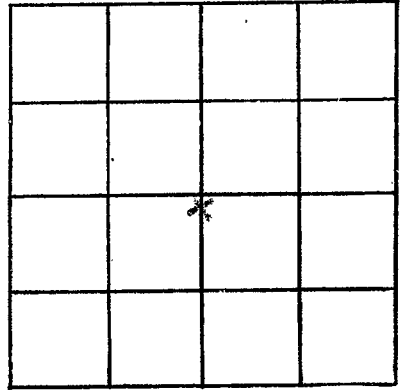

SECTION 15

Please indicate well location X.

ADDITIONAL INFORMATION

If more than one screen,
show locations of each on sketch.