

PIKE
D123
1-7-71

MISSISSIPPI
BOARD OF WATER COMMISSIONERS
416 North State Street
Jackson, Mississippi 39201

CODED

WATER WELL DRILLERS LOG

7 Jan 1971 *JH Waterwell* PIKE
date well completed firm name county well located

LANDOWNER:
Maurice Fermon
McComb
(mailing address)

description of formations encountered	from	to
<i>Clay</i>	<i>0</i>	<i>15</i>
<i>Rock Clay</i>	<i>15</i>	<i>35</i>
<i>Chalky Sand</i>	<i>35</i>	<i>65</i>
<i>Sand</i>	<i>65</i>	<i>86</i>

WELL LOCATION:
sec *23* T *3* N R *7* E
1 miles *West* of *McComb*
(distance) (direction) (nearest town)

WELL PURPOSE:
(home, irrigation, municipal, industrial)

- WELL COMPLETION DATA:
- (1) diameter (inches) *4*
 - (2) total depth (feet) *86*
 - (3) static water level (feet) *65* below above top of ground.
 - (4) casing *1* *80*
(material) (depth)
(size) if telescope see back.
 - (5) screen *6* *80*
(length) (depth to top)
1/2 *1*
(size) (material)
 - (6) pump *1* *8*
(HP) (yield gpm)
Electric
(type power)
 - (7) electric log (yes or no)
 - (organization running log)
 - (8) how well bottom plugged *wood*

CODED


FEB 20 1971

MISS. BD. OF
WATER COMM.

DRILLERS REMARKS:

If well telescopes please sketch and show depths.

GROUND LEVEL

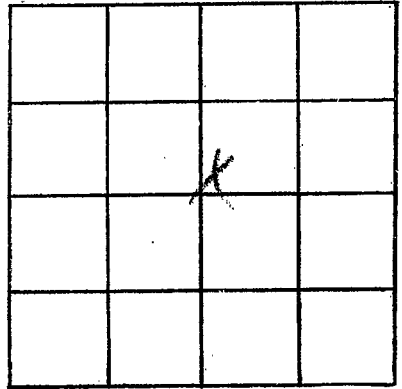

SECTION 28

Please indicate well location X.

ADDITIONAL INFORMATION

If more than one screen, show locations of each on sketch.