

PIKE
D 125
3-8-71

MISSISSIPPI
BOARD OF WATER COMMISSIONERS
416 North State Street
Jackson, Mississippi 39201

CODED

WATER WELL DRILLERS LOG

E. M. Smith 1971 J.P. Waterwell Pike
date well completed firm name county well located

LANDOWNER:
Charles Watson
McComb, Miss.
(mailing address)

WELL LOCATION:
sec 34 T 3 N R 7 E
3 miles South of McComb
(distance) (direction) (nearest town)

WELL PURPOSE:
(home, irrigation, municipal, industrial)

WELL COMPLETION DATA:

(1) diameter (inches) 4

(2) total depth (feet) 125

(3) static water level (feet) 75 below above top of ground.

(4) casing PI 119
(material) (depth)
(size) if telescope see back.

(5) screen 6 119
(length) (depth to top)
4 PI
(size) (material)

(6) pump 3/4 6
(HP) (yield gpm)
Electric
(type power)

(7) electric log (yes or no)

(organization running log)

(8) how well bottom plugged Water

description of formations encountered	from	to
Clay	0	15
Red clay gravel	15	35
Clay & gravel	35	50
Sand & gravel	50	70
Sand gravel	70	125

CODED


MAY 6 1971

DRILLERS REMARKS:

MISS. BD. OF
WATER COMMISSIONERS

If well telescopes please sketch and show depths.

GROUND LEVEL

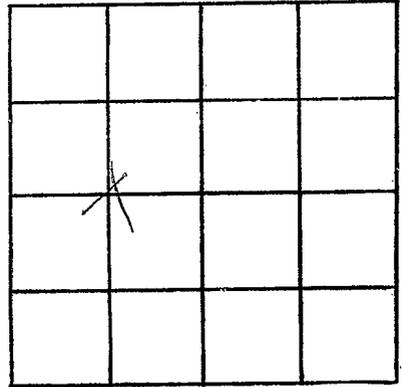

SECTION 34

Please indicate well location X.

ADDITIONAL INFORMATION

If more than one screen,
show locations of each on sketch.