

MISSISSIPPI
BOARD OF WATER COMMISSIONERS
416 North State Street
Jackson, Mississippi 39201

CODED

WATER WELL DRILLERS LOG

PIKE
D 126
3-29-71

29 March 1971 J & J Water Well Pike
date well completed firm name county well located

LANDOWNER:
Charles Schwantz
M. Comb
(mailing address)

description of formations encountered	from	to
<u>clay</u>	<u>0</u>	<u>25</u>
<u>chalk</u>	<u>25</u>	<u>65</u>
<u>sand</u>	<u>65</u>	<u>80</u>
<u>red</u>	<u>80</u>	<u>123</u>

WELL LOCATION:
sec. 15 T 3 (N) R 7 (E)
2 miles WT of McComb
(distance) (direction) (nearest town)

WELL PURPOSE:
(home, irrigation, municipal, industrial)

- WELL COMPLETION DATA:
- (1) diameter (inches) 4 1/2
 - (2) total depth (feet) 123
 - (3) static water level (feet) 80 below above top of ground.
 - (4) casing pl, 117,
(material) (depth)
(size) if telescope see back.
 - (5) screen 6, 117
(length) (depth to top)
4, pl
(size) (material)
 - (6) pump 1/2, 8
(HP) (yield gpm)
Elect
(type power)
 - (7) electric log (yes or no)

CODED

(organization running log)
(8) how well bottom plugged wood


MAY 6 - 1971

MISS. BD. OF
WATER COMM.

DRILLERS REMARKS:

If well telescopes please sketch and show depths.

GROUND LEVEL

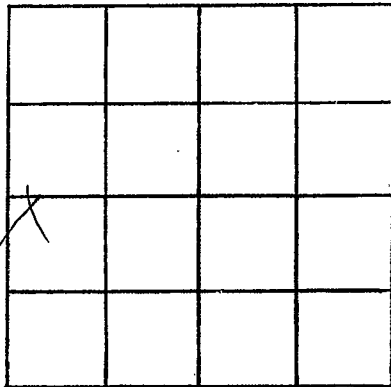

SECTION 15

Please indicate well location X.

ADDITIONAL INFORMATION

If more than one screen,
show locations of each on sketch.