

PIKE  
 D 127  
 4-30-71

MISSISSIPPI  
 BOARD OF WATER COMMISSIONERS  
 416 North State Street  
 Jackson, Mississippi 39201

**CODED**

WATER WELL DRILLERS LOG

4-30 1970 *Edgewood well dr* *Pike*  
 date well completed firm name county well located

LANDOWNER:

*Homey May*  
*R.R. McComb, Mrs.*  
 (mailing address)

description of formations encountered

from to

*Red Clay* 0 20  
*Red Sand* 20 106  
*Coarse Sand* 106 112

WELL LOCATION:

sec. 15 T. 30 N. R. 7 E.  
 S W  
1 miles W of McComb  
 (distance) (direction) (nearest town)

WELL PURPOSE:

*Flow*  
 (home, irrigation, municipal, industrial)

WELL COMPLETION DATA:

- (1) diameter (inches) 4
- (2) total depth (feet) 112
- (3) static water level (feet) 70 below above top of ground.
- (4) casing plastic, 106,  
 (material) (depth)  
4 if telescope see back.  
 (size)
- (5) screen 6, 106  
 (length) (depth to top)  
4, plastic  
 (size) (material)
- (6) pump 112, 6  
 (HP) (yield gpm)  
Electric  
 (type power)
- (7) electric log yes  
 (yes or no)

**CODED**

MAY 10 1971


MISS. RD. OF  
 WATER COMMISSIONERS

(8) how well bottom plugged wood plug

DRILLERS REMARKS:

If well telescopes please  
sketch and show depths.

GROUND LEVEL

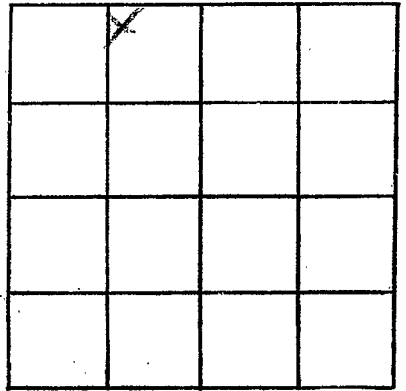

SECTION 15

Please indicate well location X.

ADDITIONAL INFORMATION

If more than one screen,  
show locations of each on sketch.