

PIKE
 D132
 5-29-71

MISSISSIPPI
 BOARD OF WATER COMMISSIONERS
 416 North State Street
 Jackson, Mississippi 39201

CODED

WATER WELL DRILLERS LOG

29 May 1971 date well completed
 S.P. Water Well firm name
 Pike county well located

LANDOWNER:
 George Glass
 (mailing address)
 WELL LOCATION:
 sec 29 T 13 N R 7 E
 S W
 4 miles west of McComb
 (distance) (direction) (nearest town)

description of formations encountered	from	to
Clay	0	17
Clay	17	25
Clay	25	50
Sand & Gravel	50	85

WELL PURPOSE:
 (home, irrigation, municipal, industrial)

WELL COMPLETION DATA:
 (1) diameter (inches) 4
 (2) total depth (feet) 85
 (3) static water level (feet) 60 below top of ground.
 (4) casing (material) 79 (depth)
 (size) if telescope see back.
 (5) screen 6 79 (length) (depth to top)
 4 (size) (material)
 (6) pump 1/2 8 (HP) (yield gpm)
 Elect (type power)
 (7) electric log (yes or no)
 (organization running log)
 (8) how well bottom plugged wood

CODED


JUL 14 1971

DRILLERS REMARKS:

MISS DR 68
 MISSISSIPPI
 WATER COMMISSION

If well telescopes please
sketch and show depths.

GROUND LEVEL

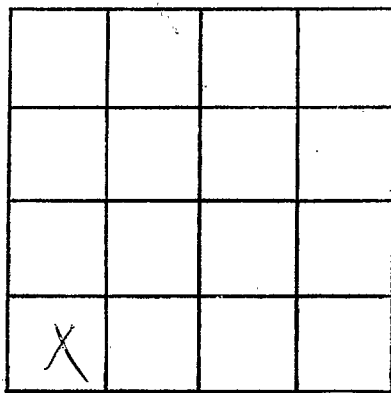

SECTION 27

Please indicate well location X.

ADDITIONAL INFORMATION

If more than one screen,
show locations of each on sketch.