

Pike  
D135  
9-13-71

MISSISSIPPI  
BOARD OF WATER COMMISSIONERS  
416 North State Street  
Jackson, Mississippi 39201

**CODED**

WATER WELL DRILLERS LOG

9-13 1971 *Felt well drilled here* *Pike*  
date well completed firm name county well located

LANDOWNER: *Southwest Miss Printing Co.*  
*P.O. Box 377*  
(mailing address)

description of formations encountered

	from	to
<i>Red Clay</i>	<i>0</i>	<i>20</i>
<i>Red sand</i>	<i>20</i>	<i>85</i>
<i>Coarse silt &amp; gravel</i>	<i>85</i>	<i>96</i>

WELL LOCATION:  
sec. *10* T. *3* N. R. *2* E.  
*1* miles *W* of *McComb*  
(distance) (direction) (nearest town)

WELL PURPOSE: *Water for home*  
(home, irrigation, municipal, industrial)

WELL COMPLETION DATA:  
 (1) diameter (inches) *4*  
 (2) total depth (feet) *96*  
 (3) static water level (feet) *50* below top of ground.  
 (4) casing *4* (size) *plastic* (material) *90* (depth).  
 If telescope see back.  
 (5) screen *6* (length) *90* (depth to top).  
*4* (size) *plastic* (material)  
 (6) pump *1/2* (HP) *10* (yield-gpm)  
*etc.* (type-power)  
 (7) electric log *no* (yes-or-no)  
 (organization-running-log)  
 (8) how well bottom plugged *well plug*

**CODED**


OCT 28 1971

DRILLERS REMARKS:

MISS. SHEETS AND NOTES

If well telescopes please sketch and show depths.

GROUND LEVEL

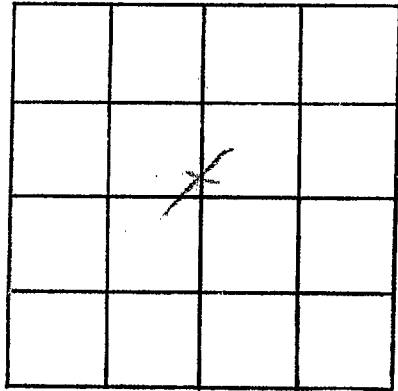

SECTION 10

Please indicate well location X.

ADDITIONAL INFORMATION

If more than one screen,  
show locations of each on sketch.