

**MISSISSIPPI  
BOARD OF WATER COMMISSIONERS  
416 North State Street  
Jackson, Mississippi 39201**

**WATER WELL DRILLERS LOG**

**CODED**

Pike  
D136  
9-1-71

1 Sept 1971 JC Jiff Water Well Pike  
date well completed firm name county well located

**LANDOWNER:**  
Cliff Thompson  
Sumner  
(mailing address)

description of formations encountered	from	to
Clay	0	15
Chalky clay	15	25
Coal bed	25	50
Sand shell	50	65
Chalk	65	85
Gravel	85	115

**WELL LOCATION:**  
sec. 17 T-3 N R-7 E  
5 miles West of Sumner  
(distance) (direction) (nearest town)

**WELL PURPOSE:**  
(home, irrigation, municipal, industrial)

- WELL COMPLETION DATA:**
- (1) diameter (inches) 4
  - (2) total depth (feet) 115
  - (3) static water level (feet) 70 below above top of ground.
  - (4) casing (material) 1009 (depth) 1009  
(size) if telescope see back.
  - (5) screen (length) 61 (depth to top) 1.09  
(size) 4 (material) PI
  - (6) pump (HP) 1/2 (yield gpm) 8  
(type power) Electric
  - (7) electric log (yes or no) \_\_\_\_\_  
(organization running log) \_\_\_\_\_

**CODED**


(8) how well bottom plugged wood

**DRILLERS REMARKS:**

NOV 10 1971  
MISS. Bd. OF  
WATER COMM.  
NOV 1 1971

If well telescopes please sketch and show depths.

GROUND LEVEL

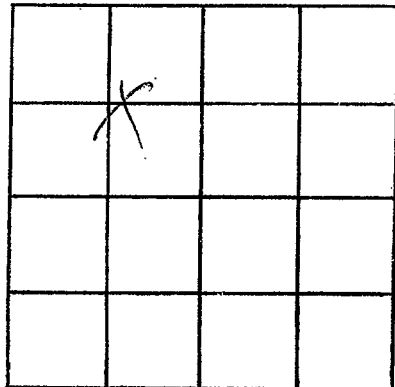

SECTION 17

Please indicate well location X.

ADDITIONAL INFORMATION

If more than one screen,  
show locations of each on sketch.