

MISSISSIPPI
 BOARD OF WATER COMMISSIONERS FEB - 7 1972
 416 North State Street
 Jackson, Mississippi 39201

WATER WELL DRILLERS LOG

MISS. BD. OF

CODED

Pike
 D138
 1-27-72

Jan 27 1972 date well completed
 Chester Kelms firm name
 county well located

LANDOWNER: Mrs. E. S. Sudean
 Rt 3, McComb (mailing address)

description of formations encountered	from	to
clay gravel	0	14
red chalk	14	22
red sand	22	54
sand & gravel	54	62
red chalk	62	73
sand & gravel	73	85

WELL LOCATION:
 sec. 23 T 3 N R 7 E
 1/2 miles SW of McComb (distance) (direction) (nearest town)

WELL PURPOSE: home (home, irrigation, municipal, industrial)

WELL COMPLETION DATA:
 (1) diameter (inches) 4"
 (2) total depth (feet) 85
 (3) static water level (feet) 59' below top of ground.
 (4) casing Plast. Ballast (material) (depth)
 (size) if telescope see back.
 (5) screen 61' 79' (length) (depth to top)
 4" Plast (size) (material)
 (6) pump 1/2 HP 3 (HP) (yield gpm)
 elect (type power)
 (7) electric log NO? (yes or no)


CODED

(organization running log)
 (8) how well bottom plugged wood chips

DRILLERS REMARKS: Trailer - no permits well

If well telescopes please sketch and show depths.

GROUND LEVEL

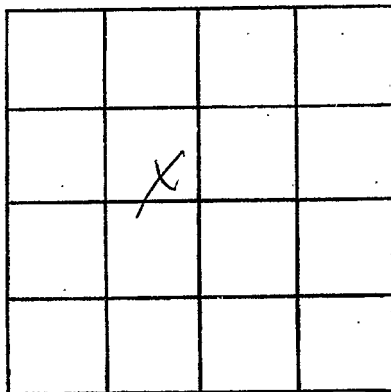

SECTION 2.3

Please indicate well location X.

ADDITIONAL INFORMATION

If more than one screen, show locations of each on sketch.