

**CODED**

MISSISSIPPI  
BOARD OF WATER COMMISSIONERS  
416 North State Street  
Jackson, Mississippi 39201

FEB 17 1972

MISSISSIPPI

**WATER WELL DRILLERS LOG**

PIKE  
D140  
12-14-71

14 Dec 1971 97 Water Well Pike  
date well completed firm name county well located

LANDOWNER:  
McComb, Miss  
McComb, Miss  
(mailing address)

description of formations encountered	from	to
<u>Clay</u>	<u>0</u>	<u>20</u>
<u>chert</u>	<u>20</u>	<u>50</u>
<u>grit</u>	<u>50</u>	<u>70</u>
<u>dark sand</u>	<u>70</u>	<u>85</u>
<u>grit</u>	<u>85</u>	<u>105</u>

WELL LOCATION:  
sec 35 T 3 N R 7 E  
1 miles N of McComb  
(distance) (direction) (nearest town)

WELL PURPOSE:  
(home, irrigation, municipal, industrial)


- WELL COMPLETION DATA:
- (1) diameter (inches) 4
  - (2) total depth (feet) 105
  - (3) static water level (feet) 60 below above top of ground.
  - (4) casing 81 99  
(material) (depth)  
(size) if telescope see back.
  - (5) screen 6 99  
(length) (depth to top)  
4 81  
(size) (material)
  - (6) pump 1/2 8  
(HP) (yield gpm)  
Electric  
(type power)
  - (7) electric log (yes or no) no  
(organization running log)
  - (8) how well bottom plugged wood

**CODED**

DRILLERS REMARKS:

If well telescopes please sketch and show depths.

GROUND LEVEL

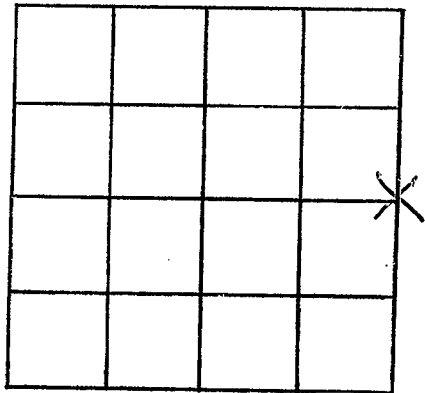

SECTION 25

Please indicate well location X.

ADDITIONAL INFORMATION

A series of horizontal lines for writing additional information.

If more than one screen,  
show locations of each on sketch.